

Wayne  
 2018  
 7/9/76

MISSISSIPPI  
 BOARD OF WATER COMMISSIONERS  
 416 North State Street  
 Jackson, Mississippi 39201

WATER WELL DRILLERS LOG

13P  
 MCILWAIN WATER WELL SERVICE WAYNE

July 9, 1976  
 date well completed

RT. firm name BOX 31  
 WAYNESBORO MISS 39267


county well located

LANDOWNER:	description of formations encountered	from	to
JOAN ROBERT COOLEY JR. Waynesboro, Miss. (mailing address)			
	" Sand	6	15
WELL LOCATION: sec. 20 T 8 N R 6 E 2 miles S of WBORO (distance) (direction) (nearest town)	Sand + gravel	15	22
	Sand + clay	22	43
WELL PURPOSE: Home (home, irrigation, municipal, industrial)	Sand	43	52
WELL COMPLETION DATA:			
(1) diameter (inches) 2"			
(2) total depth (feet) 52'			
(3) static water level (feet) 38' below top of ground.			
(4) casing PVC 48' (material) (depth) 2" if telescope see back. (size)			
(5) screen 4' 48' (length) (depth to top) 2" PVC (size) (material)			
(6) pump 1 10 (HP) (yield gpm) 220 AC (type power)			
(7) electric log no (yes or no)			
(organization running log)			
(8) how well bottom plugged			
DRILLERS REMARKS:			

RECEIVED  
 AUG 18 1976  
 MISS. Bd. OF WATER COMMISSIONERS

If well telescopes please sketch and show depths.

GROUND LEVEL

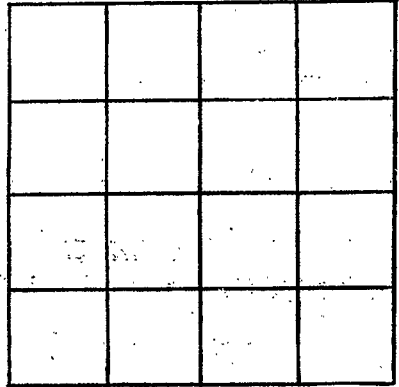

SECTION \_\_\_\_\_

Please indicate well location X.

ADDITIONAL INFORMATION

If more than one screen, show locations of each on sketch.