

Wayne
 809
 7/23/76

MISSISSIPPI
 BOARD OF WATER COMMISSIONERS
 416 North State Street
 Jackson, Mississippi 39201

WATER WELL DRILLERS LOG

July 23, 1976
 date well completed

McILWAIN WATER WELL SERVICE
 Rife name BOX 37
 WAYNESBORO MISS 39367

WAYNE
 county well located

LANDOWNER:
 ORA LEE JONES
 WAYNESBORO, MISS.
 (mailing address)


description of formations encountered	from	to
Red Clay	0	10
Red Sand	10	15
Clay	15	18
Sand	18	24

WELL LOCATION:
 sec. 17 T 8 N R 4 E
 2 miles SE of Waynesboro
 (distance) (direction) (nearest town)

WELL PURPOSE: HOME
 (home, irrigation, municipal, industrial)

- WELL COMPLETION DATA:
- (1) diameter (inches) 2"
 - (2) total depth (feet) 24'
 - (3) static water level (feet) 13' below above top of ground.
 - (4) casing PVC 20' (material) (depth)
 2" (size) If telescope see back.
 - (5) screen 4' 20' (length) (depth to top)
 2" PVC (size) (material)
 - (6) pump 1 10 (HP) (yield gpm)
 220 AC (type power)
 - (7) electric log no (yes or no)
 (organization running log)
 - (8) how well bottom plugged


DRILLERS REMARKS:

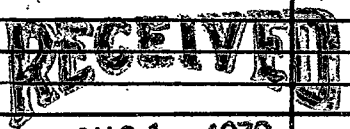

AUG 18 1976

If well telescopes please sketch and show depths.

GROUND LEVEL

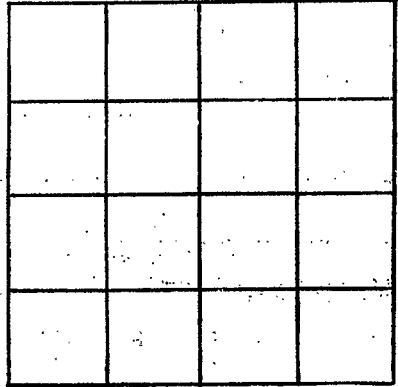

SECTION _____

Please indicate well location X.

ADDITIONAL INFORMATION

If more than one screen, show locations of each on sketch.