

Wayne
 8/6/76

MISSISSIPPI
 BOARD OF WATER COMMISSIONERS
 416 North State Street
 Jackson, Mississippi 39201

WATER WELL DRILLERS LOG
 McILWAIN WATER WELL SERVICE

13P
 Ave 6, 1976 19 RT. 2 BOX 37 WAYNESBORO MISS. 39367 Wayne county well located


LANDOWNER:	description of formations encountered	from	to
Mrs B. G. Holston	Red Clay	0	12
Rt 4 Waynesboro, Miss (mailing address)	Sand	12	23
WELL LOCATION: sec 7 T 8 S R 6 E 6 miles E of Waynesboro	Clay	23	27
	Sand & Clay	27	35
WELL PURPOSE: HOME (home, irrigation, municipal, industrial)	Sand	35	55
WELL COMPLETION DATA: (1) diameter (inches) 2"			
(2) total depth (feet) 55'			
(3) static water level (feet) 46' below top of ground			
(4) casing PVC 51' (material) (depth)			
2" (size) if telescope see back.			
(5) screen 4' 51' (length) (depth to top)			
2" PVC 008 (size) (material)			
(6) pump 1 10 (HP) (yield gpm)			
220 AC (type power)			
(7) electric log NO (yes or no)			
(organization running log)			
(8) how well bottom plugged			
DRILLERS REMARKS:			

RECEIVED
 OCT 5 1976

MISS. BD. OF WATER COMMISSIONERS

If well telescopes please
sketch and show depths.

GROUND LEVEL

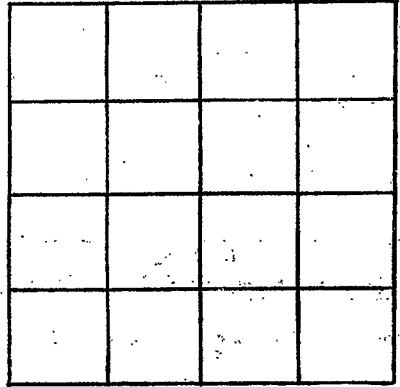

SECTION _____

Please indicate well location X.

ADDITIONAL INFORMATION

If more than one screen,
show locations of each on sketch.