

Wayne
 13P
 8/14/76

MISSISSIPPI
 BOARD OF WATER COMMISSIONERS
 416 North State Street
 Jackson, Mississippi 39201

WATER WELL DRILLERS LOG

Aug 14, 1976 19 McGILWAIN WATER WELL SERVICE Wayne
 date well completed RT. firm name BOX 37 county well located

WAYNESBORO, MISS. 39367

LANDOWNER:
 Elton James
 Waynesboro, Miss
 (mailing address)

WELL LOCATION:
 sec. 5 T 8 N R 6 E
 2 miles E of W'BORO
 (distance) (direction) (nearest town)

WELL PURPOSE: HOME
 (home, irrigation, municipal, industrial)

- WELL COMPLETION DATA:
- (1) diameter (inches) 2"
 - (2) total depth (feet) 47
 - (3) static water level (feet) 25' below top of ground.
 - (4) casing PVC 43' (material) (depth)
 2" (size) If telescope see back.
 - (5) screen 4' 43 (length) (depth to top)
 2" PVC .008 (size) (material)
 - (6) pump 3/4 12 (HP) (yield gpm)
 110 AC (type power)
 - (7) electric log no (yes or no)
- (organization running log)
- (8) how well bottom plugged

description of formations encountered	from	to
Red clay	0	5
Sand + some clay	5	14
Clay	14	25
Fine Sand + clay	25	38
Med Sand	38	47


RECEIVED
 OCT - 5 1976

MISS. BD. OF WATER COMMISSIONERS

DRILLERS REMARKS:

If well telescopes please sketch and show depths.

GROUND LEVEL

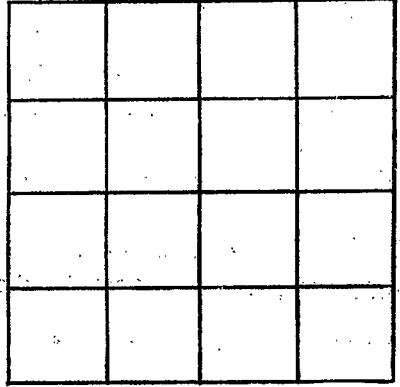

SECTION _____

Please indicate well location X.

ADDITIONAL INFORMATION

If more than one screen, show locations of each on sketch.