

WAYNE
D 2013
9/13/76

MISSISSIPPI
BOARD OF WATER COMMISSIONERS
416 North State Street
Jackson, Mississippi 39201

WATER WELL DRILLERS LOG
McILWAIN WATER WELL SERVICE

Wayne
county well located

Sept 13, 76
date well completed

RT. 2 BOX 37
WAYNESBORO, MISS 39367


LANDOWNER:	description of formations encountered	from	to
Vernon Dunn			
Rt 4 Waynesboro, Miss (mailing address)	Red Clay	0	8
WELL LOCATION:	Red Sand	8	25
sec. 5 T 8 N R 6 E S W	White Sand	25	40
2 miles E of W'boro (distance) (direction) (nearest town)	Sand & Clay	40	58
WELL PURPOSE: Home (home, irrigation, municipal, industrial)	Sand	58	67
WELL COMPLETION DATA:			
(1) diameter (inches) 2"			
(2) total depth (feet) 67'			
(3) static water level (feet) 48' below top of ground.			
(4) casing PVC 63' (material) (depth)			
2" If telescope see back. (size)			
(5) screen 4' 63' (length) (depth to top)			
2" PVC .008 (size) (material)			
(6) pump 3/4 4 (HP) (yield gpm)			
220 AC (type power)			
(7) electric log no (yes or no)			
(organization running log)			
(8) how well bottom plugged			
DRILLERS REMARKS:			

RECEIVED
OCT - 5 1976

MISS. Bd. OF WATER COMMISSIONERS

If well telescopes please sketch and show depths.

GROUND LEVEL

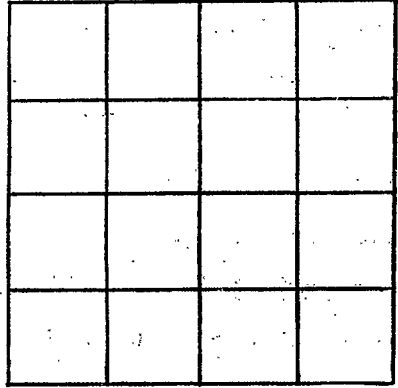

SECTION _____

Please indicate well location X.

ADDITIONAL INFORMATION

If more than one screen, show locations of each on sketch.