

WAYNE
 2005
 12/31/76

MISSISSIPPI
 BOARD OF WATER COMMISSIONERS
 416 North State Street
 Jackson, Mississippi 39201

WATER WELL DRILLERS LOG

McILWAIN WATER WELL SERVICE

Wayne

Dec. 31 1976
 date well completed

RT. 7 BOX 37
 firm name
 WAYNESBORO MISS. 39367

county well located


LANDOWNER:	description of formations encountered	from	to
Mr. Elton Hellinghead			
Waynesboro, Miss. (mailing address)	Sand + Clay	12	21
WELL LOCATION:	Sand	21	28
sec. 21 T. 8 N. R. 6 E. 3 miles SE of W'boro (distance) (direction) (nearest town)	Clay	28	35
WELL PURPOSE: Home (home, irrigation, municipal, industrial)	Sand + Clay	35	60
WELL COMPLETION DATA:	Sand	60	70
(1) diameter (inches) 2"			
(2) total depth (feet) 70'			
(3) static water level (feet) 36' below top of ground.			
(4) casing PVC, 65' (material) (depth)			
(size) If telescope see back.			
(5) screen 5' 65' (length) (depth to top)			
2" PVC (size) (material)			
(6) pump 1/2 8 (HP) (yield gpm)			
110 AC (type power)			
(7) electric log No (yes or no)			
(organization running log)			
(8) how well bottom plugged			
DRILLERS REMARKS:			

RECEIVED
 JAN 24 1977

MISS. Bd. OF WATER COMMISSIONERS

If well telescopes please sketch and show depths.

GROUND LEVEL

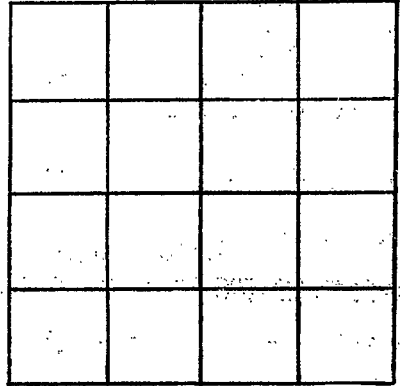

SECTION _____

Please indicate well location X.

ADDITIONAL INFORMATION

If more than one screen, show locations of each on sketch.