

Wayne
 12-15-76

MISSISSIPPI
 BOARD OF WATER COMMISSIONERS
 416 North State Street
 Jackson, Mississippi 39201

WATER WELL DRILLERS LOG

12-15-76 date well completed
 13P 76 CARRS well SERV firm name
 WAGNER county well located

LANDOWNER: LAVELL JAMES
WAGNER
 (mailing address)

WELL LOCATION:
 sec 5 T 8 (N) R 6 (E)
2 miles East of Wab
 (distance) (direction) (nearest town)

WELL PURPOSE: Home
 (home, irrigation, municipal, industrial)

WELL COMPLETION DATA:
 (1) diameter (inches) 2"
 (2) total depth (feet) 57
 (3) static water level (feet) 31 below above top of ground.
 (4) casing PVC 49
 (material) (depth)
 (size) if telescope see back.
 (5) screen 8' 49'
 (length) (depth to top)
1/2" steel (7 slot)
 (size) (material)
 (6) pump 1/2 3 1/2
 (HP) (yield gpm)
elect
 (type power)
 (7) electric log No
 (yes or no)
 (organization running log)
 (8) how well bottom plugged 1/4 Galv
plug


| description of formations encountered | from to | |
|---------------------------------------|---------|------|
| | feet | feet |
| Top Soil | 0 | 1 |
| yellow sd | 1 | 15 |
| yellow + white clay | 15 | 23 |
| Pink + white clay | 23 | 30 |
| Fine white sd | 30 | 57 |
| Yellow Clay w/ Brown Rock | 57 | 68 |

RECEIVED
 FEB 16 1977

DRILLERS REMARKS:

If well telescopes please sketch and show depths.

GROUND LEVEL

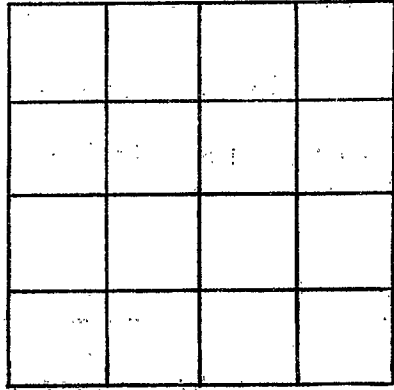

SECTION _____

Please indicate well location X.

ADDITIONAL INFORMATION

If more than one screen, show locations of each on sketch.