

**MISSISSIPPI
BOARD OF WATER COMMISSIONERS**
416 North State Street
Jackson, Mississippi 39201

WAYNE

φ 2007

1-13-77

Jan 13

1977 Porter Drilling & Log

Wayne

date well completed

firm name

county well located

WATER WELL DRILLERS LOG

LANDOWNER: Elton Craywell

description of formations encountered

from

to

At 4 Waynesboro

(mailing address)

red clay	0	15
sand & pebbles gravel	15	35
clay	35	60
sand	60	67
clay	67	75
sand	75	105
clay	105	125
white mixed fine sand	125	158
hard mixed fine sand		
sand	158	180
stagnant white steel		
oil red sand		

WELL LOCATION:

sec. 35 T. 8 N. R. 6 E. W
5 miles S.E. Waynesboro
 (distance) (direction) (nearest town)

WELL PURPOSE: chicken houses
 (home, irrigation, municipal, industrial)

WELL COMPLETION DATA:

- (1) diameter (inches) 4"
- (2) total depth (feet) 149'
- (3) static water level (feet) 89' below top of ground
- (4) casing P.V.C. 137'
 (material) (depth)
4" If telescope see back.
 (size)
- (5) screen 10' 137'
 (length) (depth to top)
2 1/2" below SS.
 (size) (material)
- (6) pump 1 1/2 23
 (HP) (yield gpm)
- (7) electric log dec.
 (type power)
- (7) electric log no
 (yes or no)

(organization running log)

(8) how well bottom plugged
backwash valve


DRILLERS REMARKS:

RECEIVED

FEB - 7 1977

If well telescopes please sketch and show depths.

GROUND LEVEL

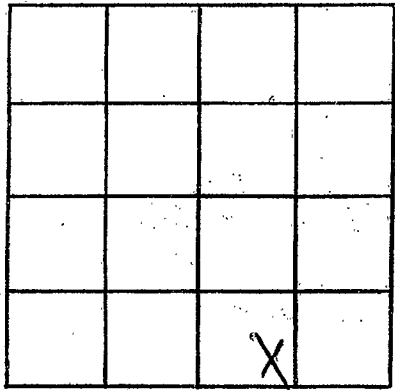

SECTION 35

Please indicate well location X.

ADDITIONAL INFORMATION

If more than one screen,
show locations of each on sketch.