

Wayne
 # 2030
 6-17-77

MISSISSIPPI
 BOARD OF WATER COMMISSIONERS
 416 North State Street
 Jackson, Mississippi 39201

WATER WELL DRILLERS LOG

McILWAIN WATER WELL SERVICE

June 17 1977
 date well completed

RT. 2 BOX 37
 firm name
 WAYNESBORO, MISS. 39367


Wayne
 county well located

LANDOWNER:	description of formations encountered	from	to
Mary Alice Gandy Waynesboro Miss. (mailing address)			
WELL LOCATION:	Red Sand	8	14
sec. <u>17</u> T. <u>8</u> N R. <u>6</u> E S W	Clay	14	18
<u>2 1/2</u> miles <u>SE</u> of <u>Wilcox</u> (distance) (direction) (nearest town)	Sand	18	22
WELL PURPOSE: <u>home</u> (home, irrigation, municipal, industrial)	Clay	22	24
WELL COMPLETION DATA:	Sand	24	33
(1) diameter (inches) <u>2"</u>	Clay	33	45
(2) total depth (feet) <u>90'</u>	Sand + Clay	45	90
(3) static water level (feet) <u>65'</u> below top of ground. above	Sand	88	90
(4) casing <u>PVC</u> <u>85'</u> (material) (depth)			
<u>2"</u> (size) if telescope see back.			
(5) screen <u>5'</u> <u>85'</u> (length) (depth to top)			
<u>2"</u> <u>PVC .008</u> (size) (material)			
(6) pump <u>1</u> <u>8</u> (HP) (yield gpm)			
<u>220 AC</u> (type power)			
(7) electric log <u>No</u> (yes or no)			
(organization running log)			
(8) how well bottom plugged			
DRILLERS REMARKS:			

RECEIVED
 JUL 22 1977
 MISS. DD. OF WATER CONTROL

If well telescopes please sketch and show depths.

GROUND LEVEL

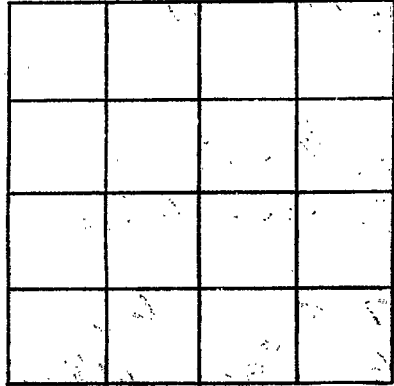

SECTION _____

Please indicate well location X.

ADDITIONAL INFORMATION

If more than one screen, show locations of each on sketch.