

WAYNE
0 3031
7/1/77

MISSISSIPPI
 BOARD OF WATER COMMISSIONERS
 416 North State Street
 Jackson, Mississippi 39201

WATER WELL DRILLERS LOG

July 1 1977 Quartz Drilling Wayne
 date well completed firm name county well located

LANDOWNER: Grady West

description of formations encountered	from	to
<u>sand & clay</u>	<u>0</u>	<u>41</u>
<u>clay</u>	<u>41</u>	<u>54</u>
<u>white limestone</u>	<u>54</u>	<u>76</u>
<u>clay</u>	<u>76</u>	<u>85</u>
<u>Wayne sand & clay streaks</u>	<u>85</u>	<u>120</u>
<u>clay & streaks</u>	<u>120</u>	<u>146</u>
<u>shaly blue rock</u>	<u>146</u>	<u>195</u>

Pl. 3 Waynesboro Miss
 (mailing address)

WELL LOCATION:

sec. 7 T. 8 N. R. 6 E.
1.1 miles E Waynesboro
 (distance) (direction) (nearest town)

WELL PURPOSE:

home
 (home, irrigation, municipal, industrial)

WELL COMPLETION DATA:

- (1) diameter (inches) 2"
- (2) total depth (feet) 195'
- (3) static water level (feet) 75 below above
 top of ground.
- (4) casing steel 146
 (material) (depth)
2" If telescope see back.
 (size)
- (5) screen none used
 (length) (depth to top)
 (size) (material)
- (6) pump 2 12
 (HP) (yield gpm)
blow
 (type power)
- (7) electric log no
 (yes or no)
 (organization running log)

10 5' 1 1/4" galv drop
of pipe

RECEIVED
 JUL 29 1977


(8) how well bottom plugged open

DRILLERS REMARKS:

MISS. BD. OF WATER COMMISSIONERS

If well telescopes please sketch and show depths.

GROUND LEVEL

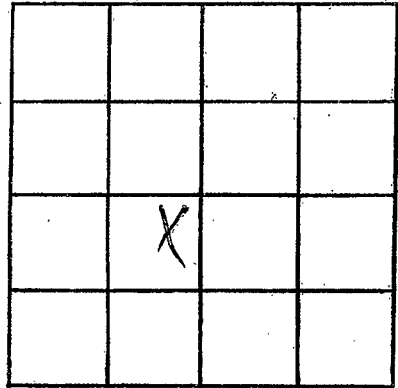

SECTION 7

Please indicate well location X.

ADDITIONAL INFORMATION

If more than one screen,
show locations of each on sketch.