

WAYNE
 Ⓟ 2030
 8/3/77

MISSISSIPPI
 BOARD OF WATER COMMISSIONERS
 416 North State Street
 Jackson, Mississippi 39201

WATER WELL DRILLERS LOG

Aug 3
 date well completed

13P
 HOLLWAIN WATER WELL SERVICE Wayne

RI. firm name 37
 WAYNESBORO MISS. 39367

county well located


LANDOWNER:	description of formations encountered	from	to
Mrs. Doreen Powe Waynesboro Miss. (mailing address)			
WELL LOCATION:	Sand	12	25
sec. <u>23</u> T. <u>8</u> N. R. <u>6</u> W.	Clay	25	31
<u>1/4</u> miles SE of <u>W'boro</u>	Sand + Clay	31	40
(distance) (direction) (nearest town)	Clay	40	52
WELL PURPOSE: <u>Home</u> (home, irrigation, municipal, industrial)	Sand	52	75
WELL COMPLETION DATA:			
(1) diameter (inches) <u>2"</u>			
(2) total depth (feet) <u>75'</u>			
(3) static water level (feet) <u>63'</u> below above top of ground.			
(4) casing <u>PVC</u> <u>70'</u> (material) (depth)			
<u>2"</u> (size) If telescope see back.			
(5) screen <u>5'</u> <u>70'</u> (length) (depth to top)			
<u>2"</u> <u>PVC .008</u> (size) (material)			
(6) pump <u>1</u> <u>3</u> (HP) (yield gpm)			
<u>220 AC</u> (type power)			
(7) electric log <u>No</u> (yes or no)			
(organization running log)			
(8) how well bottom plugged			
DRILLERS REMARKS:			

RECEIVED
 SEP 10 1977

MISSISSIPPI BOARD OF WATER COMMISSIONERS

If well telescopes please sketch and show depths.

GROUND LEVEL

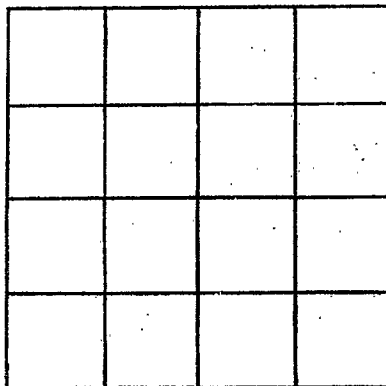

SECTION _____

Please indicate well location X.

ADDITIONAL INFORMATION

If more than one screen, show locations of each on sketch.