

WAYNE  
 2033  
 10/28/77

MISSISSIPPI  
 BOARD OF WATER COMMISSIONERS  
 416 North State Street  
 Jackson, Mississippi 39201

WATER WELL DRILLERS LOG  
 MICHLWAIN WATER WELL SERVICE

Oct 28 1977 RT. 2 BOX 37  
 date well completed WAYNESBORO MISSISSIPPI 39367

Wayne  
 county well located

LANDOWNER:  
 W. A. Young  
 Waynesboro Miss  
 (mailing address)

description of formations encountered

| from | to |
|------|----|
| 0    | 10 |
| 10   | 23 |
| 23   | 26 |
| 26   | 28 |
| 28   | 32 |
| 32   | 35 |
| 35   | 43 |
| 43   | 55 |
| 55   | 63 |
| 63   | 68 |
| 68   | 77 |
| 77   | 91 |

WELL LOCATION:  
 sec. 35 T. 8 N R. 6 E  
 4 1/2 miles SE of Wboro  
 (distance) (direction) (nearest town)

WELL PURPOSE: Home  
 (home, irrigation, municipal, industrial)

WELL COMPLETION DATA:

(1) diameter (inches) 2"  
 (2) total depth (feet) 91'  
 (3) static water level (feet) 64 below top of ground.  
 (4) casing PVC 86' (material) (depth)  
 2" (size) if telescope see back.  
 (5) screen 5' 86' (length) (depth to top)  
 2" PVC (material)  
 (6) pump 1 @ 10 (HP) (yield gpm)  
 220 AC (type power)  
 (7) electric log No (yes or no)  
 (organization running log)  
 (8) how well bottom plugged


DRILLERS REMARKS:

RECEIVED  
 NOV 11 1977

PER COMM

If well telescopes please sketch and show depths.

GROUND LEVEL

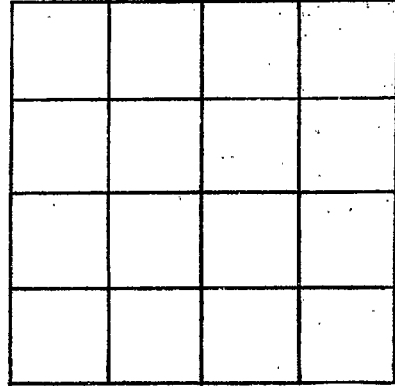

SECTION \_\_\_\_\_

Please indicate well location X.

ADDITIONAL INFORMATION

If more than one screen,  
show locations of each on sketch.