

Wayne  
 5034  
 Nov. 2, 1977

MISSISSIPPI  
 BOARD OF WATER COMMISSIONERS  
 416 North State Street  
 Jackson, Mississippi 39201

13P

WATER WELL DRILLERS LOG

McGOWAN WATER WELL SERVICE

Wayne

Nov. 2  
 date well completed

RT. 2, firm home 34  
 WAYNESBORO, MISS 39367

Wayne  
 county well located

| LANDOWNER:   | description of formations encountered | from | to  |
|--|---------------------------------------|------|-----|
| Johnnie Walker<br>Waynesboro, Miss.<br>(mailing address)                               |                                       |      |     |
| WELL LOCATION:   | SAND                                  | 12   | 45  |
| sec. 17 T. 8 N R. 6 E<br>2 miles SE of W'boro<br>(distance) (direction) (nearest town) | SAND + CLAY                           | 45   | 70  |
| WELL PURPOSE: Home<br>(home, irrigation, municipal, industrial)                        | CLAY                                  | 70   | 80  |
| WELL COMPLETION DATA:  | SAND + CLAY                           | 80   | 101 |
| (1) diameter (inches) 2"   |                                       |      |     |
| (2) total depth (feet) 101'  |                                       |      |     |
| (3) static water level (feet) 72' below top of ground.                                 |                                       |      |     |
| (4) casing PVC 96'<br>(material) (depth)<br>2" if telescope see back.<br>(size)        |                                       |      |     |
| (5) screen 5' 96'<br>(length) (depth to top)<br>2" PVC<br>(size) (material)            |                                       |      |     |
| (6) pump 1 5<br>(HP) (yield gpm)<br>110 AC<br>(type power)                             |                                       |      |     |
| (7) electric log No<br>(yes or no)   |                                       |      |     |
| (organization running log)   |                                       |      |     |
| (8) how well bottom plugged  |                                       |      |     |
| DRILLERS REMARKS:  |                                       |      |     |


RECEIVED

NOV 11 1977

MISS. BD. OF WATER COMM

If well telescopes please  
sketch and show depths.

GROUND LEVEL

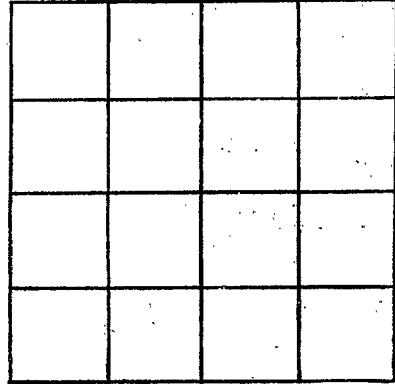

SECTION \_\_\_\_\_

Please indicate well location X.

ADDITIONAL INFORMATION

If more than one screen,  
show locations of each on sketch.