

WAYNE
 8035
 3-21-77

MISSISSIPPI
 BOARD OF WATER COMMISSIONERS
 416 North State Street
 Jackson, Mississippi 39201

WATER WELL DRILLERS LOG

McILWAIN WATER WELL SERVICE

March 21 1977
 date well completed

RT. 6 BOX 37
 firm name
 WAYNESBORO, MISS. 39367


Wayne
 county/well located

LANDOWNER:	description of formations encountered	from	to
known Joe Busby Waynesboro, Miss. (mailing address)	Red Clay	0	5
WELL LOCATION: sec. 9 T 8 N R 6 E 3 miles E of Wboro (distance) (direction) (nearest town)	Mixed Clay	5	14
WELL PURPOSE: None (home, irrigation, municipal, industrial)	Sand	14	30
WELL COMPLETION DATA: (1) diameter (inches) 2"	Sand & Clay	30	40
(2) total depth (feet) 85'	Clay	40	53
(3) static water level (feet) 53' below top of ground.	Fine Sand	55	71
(4) casing PVC 80' (material) (depth) 2" (size) if telescope see back.	Sand & Clay	71	75
(5) screen 5' 80' (length) (depth to top)	Med. Sand	75	85
2" PVC .008 (size) (material)			
(6) pump 1 8 (HP) (yield gpm)			
220 AC (type power)			
(7) electric log NO (yes or no)			
(organization running log)			
(8) how well bottom plugged			
DRILLERS REMARKS:			

RECEIVED
 MAY 21 1977
 MISS. BD. OF WATER COMMISSIONERS

If well telescopes please sketch and show depths.

GROUND LEVEL

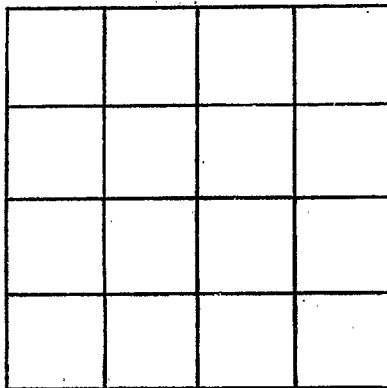

SECTION _____

Please indicate well location X.

ADDITIONAL INFORMATION

If more than one screen,
show locations of each on sketch.