

WAYNE
 D 2034
 4-2-77

MISSISSIPPI
 BOARD OF WATER COMMISSIONERS
 416 North State Street
 Jackson, Mississippi 39201

WATER WELL DRILLERS LOG

April 2, 1977
 date well completed

MILWAIN WATER WELL SERVICE Wayne
 RT. firm name 37 county well located


LANDOWNER:	description of formations encountered	from	to
Rick Thames	Red Clay	0	14
Waynesboro, Miss. (mailing address)	Red Sand	14	25
WELL LOCATION:	Sand	25	30
sec. 35 T 8 N R 6 W	Sand + Clay	30	35
5 miles SE of W'boro (distance) (direction) (nearest town)	Sand	35	52
WELL PURPOSE: Home (home, irrigation, municipal, industrial)	Clay	52	78
WELL COMPLETION DATA:	Sand	78	87
(1) diameter (inches) 2"			
(2) total depth (feet) 87'			
(3) static water level (feet) 78' below top of ground			
(4) casing PVC 82' (material) (depth)			
2" If telescope see back. (size)			
(5) screen 5' 82' (length) (depth to top)			
2" PVC 608 (size) (material)			
(6) pump 1 5 (HP) (yield gpm)			
220 AC (type power)			
(7) electric log No (yes or no)			
(organization running log)			
(8) how well bottom plugged			
DRILLERS REMARKS:			

RECEIVED
 MAY 31 1977

MISS. BD. OF WATER COMM

If well telescopes please sketch and show depths.

GROUND LEVEL

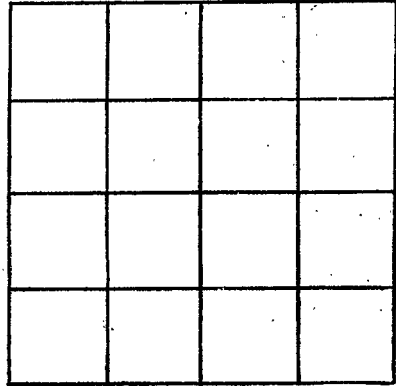

SECTION _____

Please indicate well location X.

ADDITIONAL INFORMATION

A series of horizontal lines for recording additional information.

If more than one screen, show locations of each on sketch.