

WAYNE
 # 2037
 5-2-77

MISSISSIPPI
 BOARD OF WATER COMMISSIONERS
 416 North State Street
 Jackson, Mississippi 39201

WATER WELL DRILLERS LOG
 MCILWAIN WATER WELL SERVICE

May 2 1977 RT. 2, BOX 37 Wayne
 date well completed name county well located
 WAYNESBORO, MISS. 39367


LANDOWNER:	description of formations encountered	from	to
James H. Evans Waynesboro Miss (mailing address)	Red Clay	0	10
WELL LOCATION:	Red Sand	10	16
sec. 12 T. 8 N R. 6 W 6 miles E of W'boro (distance) (direction) (nearest town)	Clay	16	25
WELL PURPOSE: Home (home, irrigation, municipal, industrial)	Sand	25	53
WELL COMPLETION DATA:			
(1) diameter (inches) 2"			
(2) total depth (feet) 53'			
(3) static water level (feet) 35' below top of ground.			
(4) casing PVC 48' (material) (depth) 2" if telescope see back. (size)			
(5) screen 5' 48' (length) (depth to top) 2" PVC .008 (size) (material)			
(6) pump 1/2 7 (HP) (yield gpm) 110 AC (type power)			
(7) electric log No (yes or no) (organization running log)			
(8) how well bottom plugged			
DRILLERS REMARKS:			

RECEIVED
 MAY 31 1977

MISS. BD. OF WATER COMMISSIONERS

If well telescopes please sketch and show depths.

GROUND LEVEL

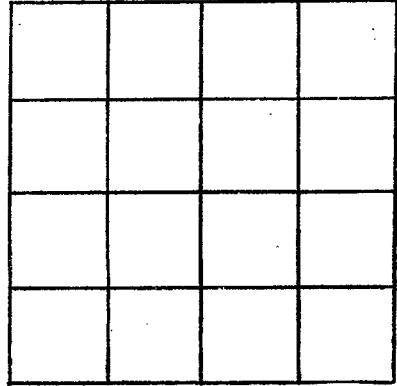

SECTION _____

Please indicate well location X.

ADDITIONAL INFORMATION

If more than one screen, show locations of each on sketch.