

WAYNE  
 \$ 2058  
 5/7/77

MISSISSIPPI  
 BOARD OF WATER COMMISSIONERS  
 416 North State Street  
 Jackson, Mississippi 39201

13P

WATER WELL DRILLERS LOG

4 May 7  
 date well completed

19 77 RT. 2, BOX 37  
 WAYNESBORO name

Wayne  
 county well located

LANDOWNER:  
 Homer Johnson  
 Waynesboro Miss  
 (mailing address)

description of formations encountered

from	to
------	----

WELL LOCATION:  
 sec. 26 T. 8 N. R. 6 E.  
 4 miles SE of Waynesboro  
 (distance) (direction) (nearest town)

Red Clay	0	5
Clay	5	9
Sand	9	12
Clay	12	25

WELL PURPOSE: Home  
 (home, irrigation, municipal, industrial)

Fine Sand + Clay	25	30
------------------	----	----

WELL COMPLETION DATA:

(1) diameter (inches) 2"

(2) total depth (feet) 56'

(3) static water level (feet) 41' below top of ground.

(4) casing PVC 51' (material) (depth)  
 2" if telescope see back. (size)

(5) screen 5' 51' (length) (depth to top)  
 2" PVC .008 (size) (material)

(6) pump 1 12 (HP) (yield gpm)  
 110 AC (type power)

(7) electric log No (yes or no)  
 (organization running log)

(8) how well bottom plugged

Fine Sand	30	45
Med Sand	45	56

RECEIVED  
 MAY 31 1977


MISS. BD. OF WATER COMMISSIONERS

DRILLERS REMARKS:

MISS. BD. OF WATER COMMISSIONERS

If well telescopes please sketch and show depths.

GROUND LEVEL

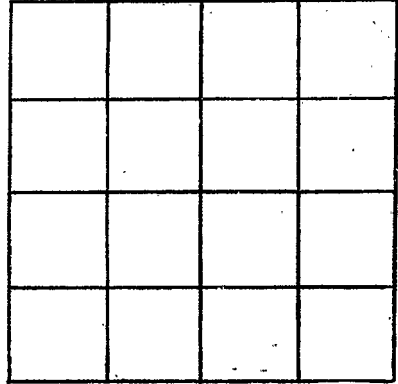

SECTION \_\_\_\_\_

Please indicate well location X.

ADDITIONAL INFORMATION

If more than one screen, show locations of each on sketch.