

Wayne  
 0 255  
 May 17, 1977

MISSISSIPPI  
 BOARD OF WATER COMMISSIONERS  
 416 North State Street  
 Jackson, Mississippi 39201

WATER WELL DRILLERS LOG

May 17 1977 <sup>13P</sup> Porter Drilling Wayne  
 date well completed firm name county well located

LANDOWNER: Gray West  
 107 Miss. Dr.  
 Haynesboro Miss.  
 (mailing address)

WELL LOCATION:  
 sec. 18 T. 20 N. R. 6 E.  
1/2 miles S.E. of Haynesboro  
 (distance) (direction) (nearest town)

WELL PURPOSE: home  
 (home, irrigation, municipal, industrial)

- WELL COMPLETION DATA:
- (1) diameter (inches) 4"
  - (2) total depth (feet) 180'
  - (3) static water level (feet) 47' (below/above top of ground)
  - (4) casing steel 153'  
 (material) (depth)
  - 4"  
 (size) if telescope see back.
  - (5) screen none used  
 (length) (depth to top)
  - (size) (material)
  - (6) pump 3/4" sub 15  
 (HP) (yield gpm)
  - elec.  
 (type power)
  - (7) electric log no  
 (yes or no)
  - (organization running log)
  - (8) how well bottom plugged open

description of formations encountered	depth	
	from	to
Clay	0	8
sand	8	18
Clay	18	32
sand & stratus	32	78
Haynesboro sand	78	113
Clay	113	153
Haynesboro sand	153	180

105' 1" deep gauge


RECEIVED  
 JUN 8 1977

DRILLERS REMARKS:

MISS. RD. OF WATER

If well telescopes please sketch and show depths.

GROUND LEVEL

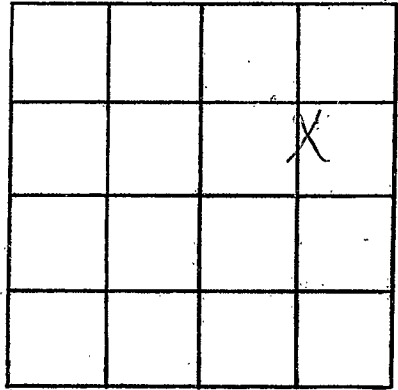

SECTION 18

Please indicate well location X.

ADDITIONAL INFORMATION

If more than one screen, show locations of each on sketch.