

WAYNE
 0 2000
 4/4/78

MISSISSIPPI
 BOARD OF WATER COMMISSIONERS
 416 North State Street
 Jackson, Mississippi 39201

WATER WELL DRILLERS LOG

April 4 1978 date well completed
 78 Parts Drilling & Log firm name
 Wayne county well located

LANDOWNER: State Corner
 Rt 4 Hainesboro Miss (mailing address)

WELL LOCATION:
 sec 26 T 80 N R 6 E
4 miles S.E. of Hainesboro (distance) (direction) (nearest town)

WELL PURPOSE: Home
 (home, irrigation, municipal, industrial)

WELL COMPLETION DATA:
 (1) diameter (inches) 2
 (2) total depth (feet) 114
 (3) static water level (feet) 72 below above top of ground.
 (4) casing PVC 109' (material) (depth)
 (size) If telescope see back.
 (5) screen 5 109' (length) (depth to top)
1/4" 6 slot S.S. (size) (material)
 (6) pump 1 8 (HP) (yield gpm)
elec (type power)
 (7) electric log no (yes or no)
 (organization running log)

(8) how well bottom plugged:
1/4" backwash valve

DRILLERS REMARKS:
shell tray above screen


| description of formations encountered | from | to |
|--|------|-----|
| rest clay | 0 | 13 |
| sand | 13 | 23 |
| clay | 23 | 63 |
| sand | 63 | 83 |
| clay | 83 | 86 |
| fine sand | 86 | 90 |
| shell coarse sand | 90 | 97 |
| " " sand clay | 97 | 105 |
| " " clay sand | 105 | 114 |
| still in construction stopped drilling | | |
| 92' 1" PVC. down pipe | | |

RECEIVED
 APR 10 1978

MISS. BD. OF WATER COMM

If well telescopes please sketch and show depths.

GROUND LEVEL

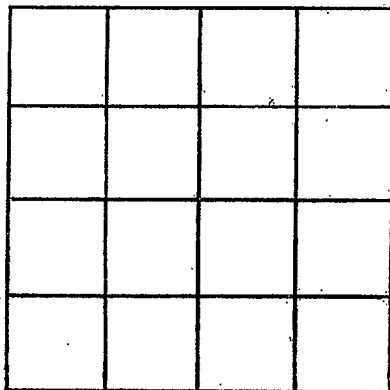

SECTION _____

Please indicate well location X.

ADDITIONAL INFORMATION

If more than one screen,
show locations of each on sketch.