

WAYNE

MISSISSIPPI
BOARD OF WATER COMMISSIONERS
416 North State Street
Jackson, Mississippi 39201

0 2041

5-24-78

WATER WELL DRILLERS LOG

May 24 1978
date well completed

McLWAIN WATER WELL SERVICE Wayne

RT # BOX 31
WAYNESBORO, MISS 39367

county well located

LANDOWNER:	description of formations encountered	from	to
Claiborne Jones Waynesboro Ms (mailing address)			
WELL LOCATION:	Red Sand	12	15
sec. 17 T. 8 N. R. 6 E. S. 8 W.	Clay	15	22
3 miles SE of W/boro (distance) (direction) (nearest town)	Coarse Sand, Pea Gravel & some Clay	22	78
WELL PURPOSE: HOME (home, irrigation, municipal, industrial)	CLAY	78	86
WELL COMPLETION DATA:	SAND	86	93
(1) diameter (inches) 2"			
(2) total depth (feet) 93			
(3) static water level (feet) 66 below top of ground.			
(4) casing PVC 88' (material) (depth)			
2" (size) if telescope see back.			
(5) screen 5' 88' (length) (depth to top)			
2" PVC .008 (size) (material)			
(6) pump 1 8 (HP) (yield gpm)			
220 AC (type power)			
(7) electric log No (yes or no)			
(organization running log)			
(8) how well bottom plugged			
DRILLERS REMARKS:			


RECEIVED

JUN 12 1978

MISS. BD. OF WATER COMMISSIONERS

If well telescopes please sketch and show depths.

GROUND LEVEL

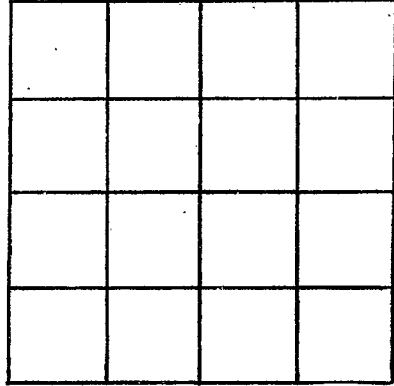

SECTION _____

Please indicate well location X.

ADDITIONAL INFORMATION

If more than one screen,
show locations of each on sketch.