

WAYNE

0 2045

5/4/78

MISSISSIPPI BOARD OF WATER COMMISSIONERS  
416 North State Street  
Jackson, Mississippi 39201

WATER WELL DRILLERS LOG

May 4 1978 Porter Drilling Co. Wayne  
date well completed firm name county well located

LANDOWNER: 2nd Concrete

description of formations encountered

from

to

Plant

Waynesboro Miss.  
(mailing address)

Clay 0 16  
sand stone clay 16 49  
Clay 49 51

WELL LOCATION:

20 8 N 6 E  
Section T R  
1 1/4 miles SE of Waynesboro  
(distance) (direction) (nearest town)

shall top above screen

WELL PURPOSE: industrial  
(home, irrigation, municipal, industrial)

WELL COMPLETION DATA:

(1) diameter (inches) 2"  
(2) total depth (feet) 49  
(3) static water level (feet) 11 below above top of ground.

(4) casing PVC 45'  
(material) (depth)

2" If telescope see back.  
(size)

(5) screen 1" 45'  
(length) (depth to top)

2" ball S.S.  
(size) (material)

(6) pump 1 15  
(HP) (yield gpm)

elec  
(type power)

(7) electric log no  
(yes or no)

(organization running log)

(8) how well bottom plugged by back wash valve

DRILLERS REMARKS:


RECEIVED

JUN 19 1978

MISS. BD. OF WATER COMM

If well telescopes please sketch and show depths.

GROUND LEVEL

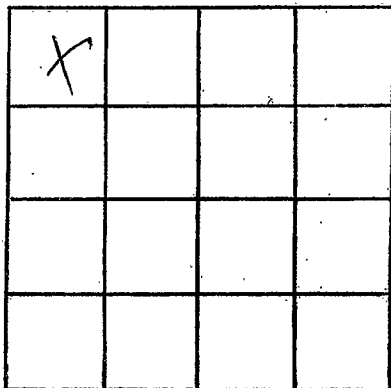

SECTION ~~12~~ 20

Please indicate well location X.

ADDITIONAL INFORMATION

If more than one screen,  
show locations of each on sketch.