

WAYNE

MISSISSIPPI
BOARD OF WATER COMMISSIONERS
416 North State Street
Jackson, Mississippi 39201

0 *2006*

5-31-78

McILWATER WATER WELL SERVICE
DRILLERS LOG
RT. 2, BOX 37

May 31
date well completed

19 78 WAYNESBORO, MISS. 39367
firm name

Wayne
county well located

LANDOWNER:	description of formations encountered	from	to
Robert J. Sanderson			
Waynesboro Ms (mailing address)	Mixed Clay	6	12
WELL LOCATION:	Sand	12	29
sec. <u>34</u> T. <u>8</u> N R. <u>6</u> W			
<u>8</u> miles <u>SE</u> of <u>W'boro</u> (distance) (direction) (nearest town)			
WELL PURPOSE: <u>Home</u> (home, irrigation, municipal, industrial)			
WELL COMPLETION DATA:			
(1) diameter (inches) <u>2"</u>			
(2) total depth (feet) <u>24'</u>			
(3) static water level (feet) <u>13'</u> below top of ground.			
(4) casing <u>PVC</u> <u>19'</u> (material) (depth)			
<u>2"</u> (size) if telescope see back.			
(5) screen <u>5'</u> <u>19'</u> (length) (depth to top)			
<u>2"</u> <u>PVC</u> <u>.008</u> (size) (material)			
(6) pump <u>1/2</u> <u>7</u> (HP) (yield gpm)			
<u>110 AC</u> (type power)			
(7) electric log <u>No</u> (yes or no)			
(organization running log)			
(8) how well bottom plugged			
DRILLERS REMARKS:			


RECEIVED

JUN 12 1978

MISS. BD. OF WATER COMMISSIONERS

If well telescopes please
sketch and show depths.

GROUND LEVEL

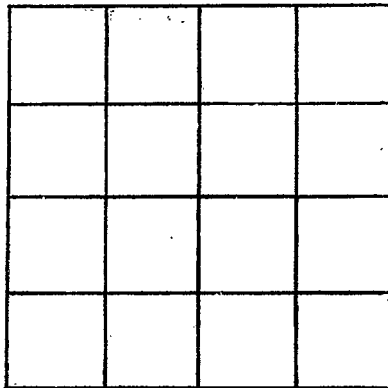

SECTION _____

Please indicate well location X.

ADDITIONAL INFORMATION

If more than one screen,
show locations of each on sketch.