

Wayne
Q 2007
8-16-79

MISSISSIPPI
 BOARD OF WATER COMMISSIONERS
 416 North State Street
 Jackson, Mississippi 39201

WATER WELL DRILLERS LOG

Aug 16 19 79 Porter Drilling Wayne
 date well completed firm name county well located

LANDOWNER: Bubba Butler
Waynesboro, Miss

description of formations encountered	from	to
<u>red clay & sand</u>	<u>0</u>	<u>17</u>
<u>sand</u>	<u>17</u>	<u>54</u>
<u>sand soft clay</u>	<u>54</u>	<u>60</u>
<u>course sand</u>	<u>60</u>	<u>66</u>
<u>soft sand</u>	<u>66</u>	<u>90</u>
<u>heavy sand</u>	<u>90</u>	<u>97</u>
<u>unconsolidated gravel</u>		

(mailing address)

WELL LOCATION:
 sec 20 T 8 N R 6 E
3 miles SE of Waynesboro
 (distance) (direction) (nearest town)

WELL PURPOSE: home
 (home, irrigation, municipal, industrial)

62' 1" P.V.C. casing pipe

WELL COMPLETION DATA:

- (1) diameter (inches) 2"
- (2) total depth (feet) 69'
- (3) static water level (feet) 39' ^{below} _{above} top of ground.
- (4) casing P.V.C., 64'
 (material) (depth)
2"
 (size) If telescope see back.
- (5) screen 5', 64'
 (length) (depth to top)
2", 6 shot S.S.
 (size) (material)
- (6) pump 1, 15
 (HP) (yield gpm)
elec.
 (type power)
- (7) electric log no
 (yes or no)

(organization running log)

(8) how well bottom plugged

2' sand shank

DRILLERS REMARKS:

shell drop


Miss. Board of Water Comm

SEP 10 1979

RECEIVED

If well telescopes please sketch and show depths.

GROUND LEVEL

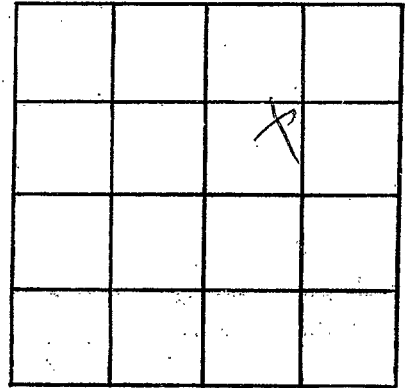

SECTION 20

Please indicate well location X.

ADDITIONAL INFORMATION

If more than one screen,
show locations of each on sketch.