

Wayne
 2048
 10-22-79

MISSISSIPPI
 BOARD OF WATER COMMISSIONERS
 416 North State Street
 Jackson, Mississippi 39201

WATER WELL DRILLERS LOG

Oct 22 1979 date well completed
 Petro Drilling, Inc. firm name
 Wayne county well located

LANDOWNER: Ethyl Palmer
 At 42 Haynesboro, Miss.
 (mailing address)

WELL LOCATION:
 sec 21 T 8 N R 6 E S W
 3 miles SE Haynesboro
 (distance) (direction) (nearest town)

WELL PURPOSE: home
 (home, irrigation, municipal, industrial)

- WELL COMPLETION DATA:
- (1) diameter (inches) 2
 - (2) total depth (feet) 53
 - (3) static water level (feet) 28 below top of ground.
 - (4) casing P.V.C. 48' (material) (depth)
 2" (size) if telescope see back.
 - (5) screen 5' 48' (length) (depth to top)
 2" (size) galot 55 (material)
 - (6) pump 1/2 (HP) 8 (yield gpm)
 elec. (type power)
 - (7) electric log no (yes or no)
 - (organization running log)
 - (8) how well bottom plugged 2' back wash valve

description of formations encountered	from to	
Clay & sand	0	21
Clay	21	24
sand to top ground	24	33
med fine clay sand	33	53
steel pipe		
sh sand		
42' 1" P.V.C. 2" pipe		

DEPT. OF NATURAL RESOURCES
 BUREAU OF LAND & WATER RESOURCES


DRILLERS REMARKS:
 steel pipe above screen

DEC 13 1979

RECEIVED

If well telescopes please sketch and show depths.

GROUND LEVEL

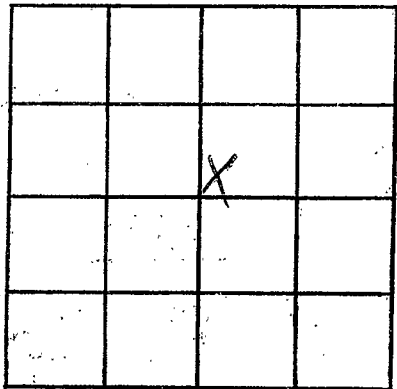

SECTION 21

Please indicate well location X.

ADDITIONAL INFORMATION

Lined area for additional information.

If more than one screen, show locations of each on sketch.