

WAYNE  
 7-18-79

MISSISSIPPI  
 BOARD OF WATER COMMISSIONERS  
 416 North State Street  
 Jackson, Mississippi 39201

WATER WELL DRILLERS LOG

McILWAIN WATER WELL SERVICE

7-18-1979 date well completed  
 WAYNE MISS. 39267 county well located  
 BOX 34

LANDOWNER:  
 Linda Williamson  
 Waynesboro Miss.  
 (mailing address)

WELL LOCATION:  
 sec. 17 T<sup>18</sup> N R. 6 E  
 3 miles S of W<sup>boro</sup>  
 (distance) (direction) (nearest town)

WELL PURPOSE: Home  
 (home, irrigation, municipal, industrial)

WELL COMPLETION DATA:

(1) diameter (inches) 2"  
 (2) total depth (feet) 100'  
 (3) static water level (feet) 72' below top of ground.  
 (4) casing PVC 95' (material) (depth)  
 2" (size) if telescope see back.  
 (5) screen 5' 95' (length) (depth to top)  
 2" PVC (size) (material)  
 (6) pump 1 6 (HP) (yield gpm)  
 110 AC (type power)  
 (7) electric log No (yes or no)  
 (organization running log)  
 (8) how well bottom plugged

description of formations encountered	from	to
Red Clay	0	12
SAND	12	15
White Clay	15	25
Fine Med White SAND	25	42
SAND & Clay	42	59
White Clay	59	63
Fine SAND	63	70
Med-Fine SAND	70	80
Med SAND	80	100

Miss Board of Water Comm.


AUG 9 1979

RECEIVED

DRILLERS REMARKS:

If well telescopes please sketch and show depths.

GROUND LEVEL

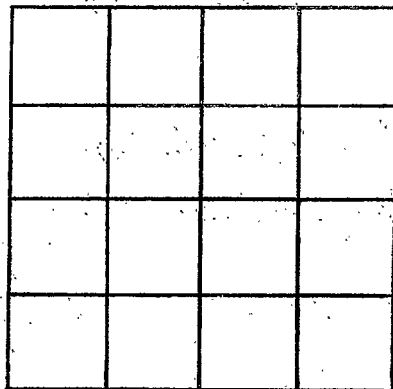

SECTION \_\_\_\_\_

Please indicate well location X.

ADDITIONAL INFORMATION

If more than one screen,  
show locations of each on sketch.