

WAYNE
 2052
 5-28-79

MISSISSIPPI
 BOARD OF WATER COMMISSIONERS
 416 North State Street
 Jackson, Mississippi 39201

WATER WELL DRILLERS LOG
 McILWAIN WATER WELL SERVICE

5-28-79 19 RT 2, BOX 37 Wayne
 date well completed WAYNESBORO, MISS. 39367 county well located

LANDOWNER:	description of formations encountered	from	to
Dwain Taylor Waynesboro, Ms. (mailing address)			
WELL LOCATION: sec. 15 T 8 N R 6 E S 2 1/2 miles E of W.boro	Clay	5	11
(distance) (direction) (nearest town)	Pink Sand	11	35
WELL PURPOSE: home (home, irrigation, municipal, industrial)	White Coarse Sand	35	60
WELL COMPLETION DATA: (1) diameter (inches) 2"	Clay	60	61
(2) total depth (feet) 90'	Purple Sand & Clay	61	65
(3) static water level (feet) 51' below top of ground	Fine Sand	65	79
(4) casing PVC 85' (material) (depth)	Med. Coarse Sand	79	90
2" (size) If telescope see back.			
(5) screen 5' 85' (length) (depth to top)			
2" PVC .008 (size) (material)			
(6) pump 1 9 (HP) (yield gpm)			
220 AC (type power)			
(7) electric log NO (yes or no)			
(organization running log)			
(8) how well bottom plugged			

Miss. Board of Water Comm.


JUN 14 1979

RECEIVED

DRILLERS REMARKS:

If well telescopes please sketch and show depths.

GROUND LEVEL

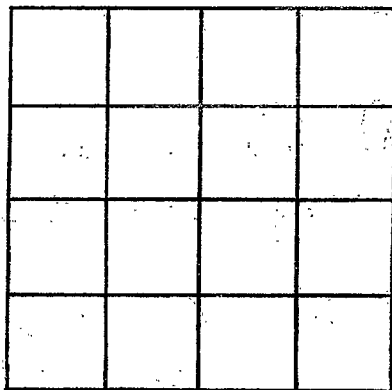

SECTION _____

Please indicate well location X.

ADDITIONAL INFORMATION

If more than one screen,
show locations of each on sketch.