

WAYNE  
 0 2084  
 02-15-79

MISSISSIPPI  
 BOARD OF WATER COMMISSIONERS  
 416 North State Street  
 Jackson, Mississippi 39201

WATER WELL DRILLERS LOG

March 15 1979 MCILWAIN WATER WELL SERVICE WAYNE  
 date well completed RT. Box 37 county well located  
 WAYNESBORO, MISS. 39367

LANDOWNER:	description of formations encountered	from	to
L. C. JONES	Red Sandy Clay	0	10
WAYNESBORO MS (mailing address)	Red SAND	10	25
WELL LOCATION: sec. 5 T 8 N R 6 E 1 miles E of W'boro (distance) (direction) (nearest town)	White SAND	25	35
WELL PURPOSE: Home (home, irrigation, municipal, industrial)	SAND & Clay	35	50
WELL COMPLETION DATA: (1) diameter (inches) 2" (2) total depth (feet) 78' (3) static water level (feet) 43' below top of ground. (4) casing PVC 73' (material) (depth) 2" (size) If telescope see back. (5) screen 5' 73' (length) (depth to top) 2" PVC .008 (size) (material) (6) pump 1 14 (HP) (yield gpm) 220 AC (type power) (7) electric log NO (yes or no) (organization running log) (8) how well bottom plugged	FINE SAND & Clay	50	65
	Med SAND	65	72
	COARSE SAND &		
	PEA GRAVEL	72	78

DRILLERS REMARKS:


Miss. Board of Water Comm.

APR 24 1979

RECEIVED

If well telescopes please sketch and show depths.

GROUND LEVEL

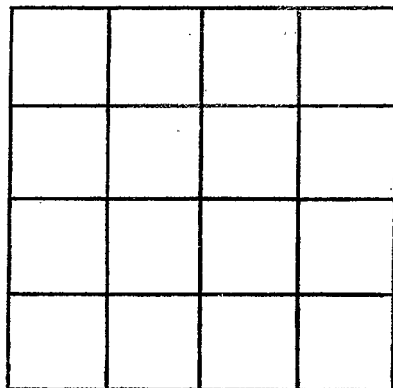

SECTION \_\_\_\_\_

Please indicate well location X.

ADDITIONAL INFORMATION.

If more than one screen, show locations of each on sketch.