

WAYNE
0 *2052*
1-19-79

MISSISSIPPI
BOARD OF WATER COMMISSIONERS
416 North State Street
Jackson, Mississippi 39201

WATER WELL DRILLERS LOG

79
Jan 19 McILWAIN WATER WELL SERVICE Wayne
date well completed RT. 2 firm BOX 37 county well located
WAYNESBORO, MISS. 39367

LANDOWNER:
Sammy Rich
Waynesboro Miss
(mailing address)

description of formations encountered	from	to
<u>Red Sandy Clay</u>	<u>0</u>	<u>15</u>
<u>Red Clay</u>	<u>15</u>	<u>19</u>
<u>SAND</u>	<u>19</u>	<u>35</u>
<u>Clay</u>	<u>35</u>	<u>37</u>
<u>SAND & Some Clay</u>	<u>37</u>	<u>97</u>

WELL LOCATION:
sec 16 T 8 N R 6 E
2 1/2 miles SE of Waynesboro
(distance) (direction) (nearest town)

WELL PURPOSE: Home
(home, irrigation, municipal, industrial)

WELL COMPLETION DATA:

(1) diameter (inches) 2"

(2) total depth (feet) 98'

(3) static water level (feet) 66' below above top of ground.

(4) casing PVC, 88'
(material) (depth)

2"
(size) If telescope see back.

(5) screen 10', 88'
(length) (depth to top)

2", PVC, 008
(size) (material)

(6) pump 1 3
(HP) (yield gpm)

220 AC
(type power)

(7) electric log No
(yes or no)

(organization running log)

(8) how well bottom plugged

DRILLERS REMARKS:


Miss. Board of Water Comm.

MAR 5 - 1979

RECEIVED

If well telescopes please sketch and show depths.

GROUND LEVEL

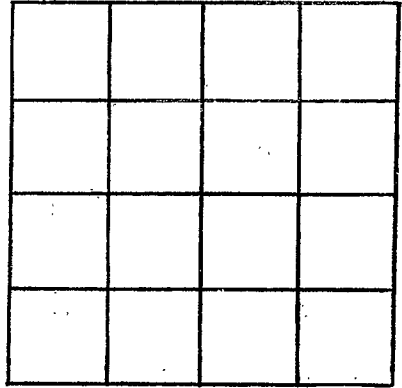

SECTION _____

Please indicate well location X.

ADDITIONAL INFORMATION

If more than one screen,
show locations of each on sketch.