

WAYNE
0 2059
7-30-79

**MISSISSIPPI
BOARD OF WATER COMMISSIONERS**
416 North State Street
Jackson, Mississippi 39201

WATER WELL DRILLERS LOG

7-30-79 date well completed Wayne
 McILWAIN WATER WELL SERVICE county well located

LANDOWNER:
Ronald Poetee
Waynesboro Miss
 (mailing address)

WELL LOCATION:
 sec. 11 T. 8 N. R. 6 E
6 miles E of Wboro
 (distance) (direction) (nearest town)

WELL PURPOSE: Home
 (home, irrigation, municipal, industrial)

WELL COMPLETION DATA:

(1) diameter (inches) 2"

(2) total depth (feet) 93'

(3) static water level (feet) 45' below top of ground.

(4) casing PVC 88'
 (material) (depth)
2" if telescope see back.
 (size)

(5) screen 5' 88'
 (length) (depth to top)
2" PVC
 (size) (material)

(6) pump 1 11
 (HP) (yield gpm)
220 AC
 (type power)

(7) electric log No
 (yes or no)

(organization running log)

description of formations encountered	from	to
SAND & SAND ROCKS	0	4
White Clay	4	8
Rock	8	8 1/2
White Chalk	8 1/2	14
Yellow Clay	14	20
Yellow Sand & Clay	20	23
White Clay & Sand	23	26
Sand	26	27
White Clay	27	46
Pink Sand & Clay	46	60
Med Coarse Sand & Clay	60	67
Pink Clay	67	74
Black Clay	74	83
Coarse Sand	83	93

Miss. Board of Water Comm.

AUG 9 1979


RECEIVED

(8) how well bottom plugged _____

DRILLERS REMARKS: _____

If well telescopes please sketch and show depths.

GROUND LEVEL

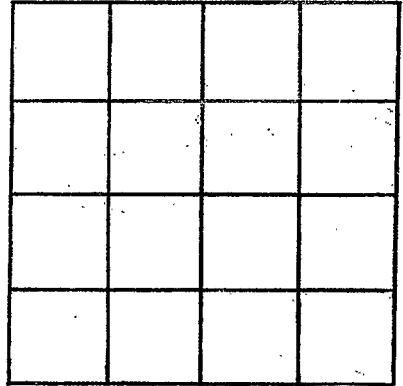

SECTION _____

Please indicate well location X.

ADDITIONAL INFORMATION

If more than one screen,
show locations of each on sketch.