

Wayne
10
2060
8-22-79

MISSISSIPPI
 BOARD OF WATER COMMISSIONERS
 416 North State Street
 Jackson, Mississippi 39201

WATER WELL DRILLERS LOG
 McILWAIN WATER WELL SERVICE

8-22 19 79 RT. 2, BOX 37 Wayne
 date well completed WAYNESBORO, MISS. 39367 county well located

LANDOWNER:
Steve Woods
Wayboro Miss.
 (mailing address)

description of formations encountered	from	to
<u>Red Sand</u>	<u>0</u>	<u>15</u>
<u>Gravel</u>	<u>15</u>	<u>25</u>
<u>FINE SAND</u>	<u>25</u>	<u>30</u>
<u>Medizum Coarse Sand</u>	<u>30</u>	<u>54</u>

WELL LOCATION:
 sec. 21 T. 8 N R. 6 E
3 miles S of Wayboro
 (distance) (direction) (nearest town)

WELL PURPOSE: Home
 (home, irrigation, municipal, industrial)

- WELL COMPLETION DATA:
- diameter (inches) 2"
 - total depth (feet) 54'
 - static water level (feet) 43' below top of ground.
 - casing PVC 49'
 (material) (depth)
2"
 (size) if telescope see back.
 - screen 5' 49'
 (length) (depth to top)
2" PVC 2"
 (size) (material)
 - pump 1 10
 (HP) (yield gpm)
220 AC
 (type power)
 - electric log No
 (yes or no)

(organization running log)
 (8) how well bottom plugged

DRILLERS REMARKS:


DEPT. OF NATURAL RESOURCES
 BUREAU OF LAND & WATER RESOURCES

NOV 16 1979

RECEIVED

If well telescopes please sketch and show depths.

GROUND LEVEL

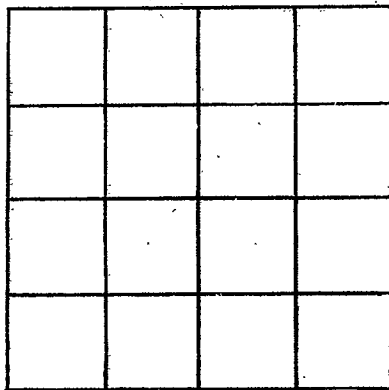

SECTION _____

Please indicate well location X.

ADDITIONAL INFORMATION

If more than one screen,
show locations of each on sketch.