

200 #
33

Wayne
0
200
8-6-79

MISSISSIPPI
BOARD OF WATER COMMISSIONERS
416 North State Street
Jackson, Mississippi 39201

WATER WELL DRILLERS LOG

8-6-1979 date well completed
Waynesboro Water Well Service firm name
Wayne county well located
RT. 2, BOX 37

LANDOWNER: WAYNESBORO, MISS. 39367
Home Johnson
Waynesboro Miss
(mailing address)

description of formations encountered	from	to
Sand	0	14
White Clay	14	17

WELL LOCATION:
sec. 34 T. 8 N R. 6 E
6 miles SE of W'boro
(distance) (direction) (nearest town)

Sand	26	27
------	----	----

WELL PURPOSE: Home
(home, irrigation, municipal, industrial)


- WELL COMPLETION DATA:
- (1) diameter (inches) 2"
 - (2) total depth (feet) 37'
 - (3) static water level (feet) 21' below above top of ground.
 - (4) casing PVC 32' (material) (depth)
2" (size) if telescope see back.
 - (5) screen 5' 32' (length) (depth to top)
2" PVC 008 (size) (material)
 - (6) pump 1 8 (HP) (yield gpm)
110 AC (type power)
 - (7) electric log No (yes or no)
 - (organization running log)
 - (8) how well bottom plugged

DRILLERS REMARKS:

DEPT. OF NATURAL RESOURCES
BUREAU OF LAND & WATER RESOURCES
NOV 16 1979
RECEIVED

If well telescopes please sketch and show depths.

GROUND LEVEL

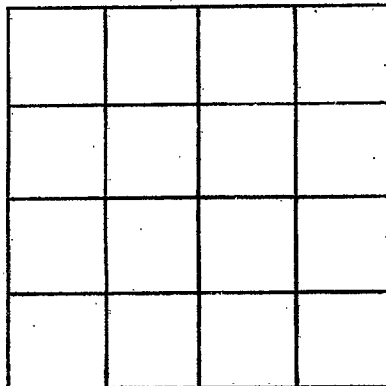

SECTION _____

Please indicate well location X.

ADDITIONAL INFORMATION

If more than one screen,
show locations of each on sketch.