

Wayne
NO 20.03
6/29/80

MISSISSIPPI
 BOARD OF WATER COMMISSIONERS
 416 North State Street
 Jackson, Mississippi 39201

WATER WELL DRILLERS LOG

May 29 1980 Porter Drilling Co Wayne
 date well completed firm name county well located

LANDOWNER: Tom L. Cox

description of formations encountered	from	to
<u>clay</u>	<u>0</u>	<u>30</u>
<u>clay & sand</u>	<u>30</u>	<u>69</u>
<u>multiple sand</u>	<u>69</u>	<u>82</u>
<u>weathered clay</u>	<u>82</u>	<u>90</u>
<u>1 8</u>		

Wayne
Atty 2749 Highway 190
 (mailing address)

WELL LOCATION:

sec 15 T 80 N R 6 E
3 miles E of Waynesboro
 (distance) (direction) (nearest town)

WELL PURPOSE: home
 (home, irrigation, municipal, industrial)

WELL COMPLETION DATA:

- (1) diameter (inches) 2"
- (2) total depth (feet) 92'
- (3) static water level (feet) 40' ^{below} top of ground.
- (4) casing PVC, 77'
 (material) (depth)
2" if telescope see back.
 (size)
- (5) screen 5', 77'
 (length) (depth to top)
2", 60 lb S.S.
 (size) (material)
- (6) pump 1, 10
 (HP) (yield gpm)
elec
 (type power)
- (7) electric log no
 (yes or no)

(organization running log)

(8) how well bottom plugged
2' sand shales

DRILLERS REMARKS:


DEPT. OF NATURAL RESOURCES
 BUREAU OF LAND & WATER RESOURCES

JUN 20 1980

RECEIVED

If well telescopes please sketch and show depths.

GROUND LEVEL

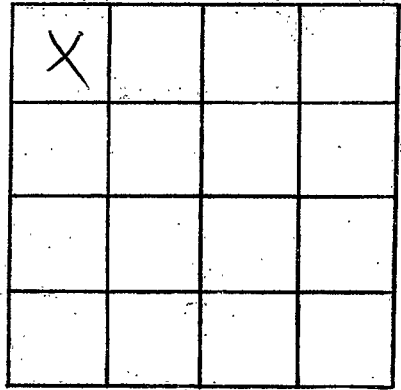

SECTION 15

Please indicate well location X.

ADDITIONAL INFORMATION

If more than one screen,
show locations of each on sketch.