

W. R. M. K.
D. J. J. J.
6/11/80

MISSISSIPPI
 BOARD OF WATER COMMISSIONERS
 416 North State Street
 Jackson, Mississippi 39201

WATER WELL DRILLERS LOG

June 11 1980 Boater Drilling & Log Wayne
 date well completed firm name county well located

LANDOWNER: Wayne On
Board of Supervisors
Beck 2 County Barn
 (mailing address)

description of formations encountered	from	to
<u>Clay</u>	<u>0</u>	<u>10</u>
<u>Clay & sand</u>	<u>15</u>	<u>45</u>
<u>sand</u>	<u>45</u>	<u>72</u>
<u>Clay some sand</u>	<u>72</u>	<u>88</u>
<u>sand some clay</u>	<u>88</u>	<u>94</u>
<u>met. firm. sand</u>	<u>94</u>	<u>100</u>
<u>stagnant or soft</u>		
<u>sand or clay</u>		

WELL LOCATION:
 sec. 10 T. 2 N. R. 6 E.
3 1/2 miles South of Waynesboro
 (distance) (direction) (nearest town)

WELL PURPOSE: County Barn
 (home, irrigation, municipal, industrial)

WELL COMPLETION DATA:
 (1) diameter (inches) 2"
 (2) total depth (feet) 100
 (3) static water level (feet) 54 below top of ground.
 (4) casing PVC 94'
 (material) (depth)
2" if telescope see back.
 (size)
 (5) screen 6' 94'
 (length) (depth to top)
2' brist S.S.
 (size) (material)
 (6) pump 1 9
 (HP) (yield gpm)
elec.
 (type power)
 (7) electric log no
 (yes or no)
 (organization running log)

20' 1" P.V.C. drop
pipe
1"

(8) how well bottom plugged 2' sand stone

DRILLERS REMARKS:


DEPT. OF NATURAL RESOURCES
 BUREAU OF LAND & WATER RESOURCES

JUN 20 1980

RECEIVED

If well telescopes please sketch and show depths.

GROUND LEVEL

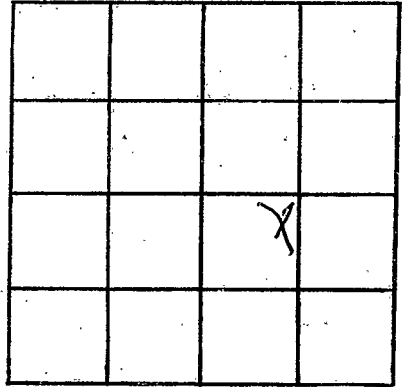

SECTION 10

Please indicate well location X.

ADDITIONAL INFORMATION

If more than one screen,
show locations of each on sketch.