

WAYNE  
 0 2005  
 12-22-80

MISSISSIPPI  
 BOARD OF WATER COMMISSIONERS  
 416 North State Street  
 Jackson, Mississippi 39201

WATER WELL DRILLERS LOG

Dec 22 1980 C. P. Clark Wtr. Wells Wayne  
 date well completed firm name county/well located

LANDOWNER: Edward  
 Holyfield, Rt. 4, Box 608  
 Waynesboro, Miss  
 (mailing address)

WELL LOCATION:  
 sec. 27 T. 8 N R. 6 E  
 1.5 miles SE of Waynesboro  
 (distance) (direction) (nearest town)

WELL PURPOSE: none  
 (home, irrigation, municipal, industrial)

- WELL COMPLETION DATA:
- (1) diameter (inches) 2
  - (2) total depth (feet) 160
  - (3) static water level (feet) 83 below top of ground.
  - (4) casing Galv 155' (material) (depth)
  - (size) If telescope see back.
  - (5) screen 5' 155' (length) (depth to top)  
 1 1/4" Stainless Steel (size) (material)
  - (6) pump 1 4 1/2 (HP) (yield gpm)  
 220v (type power)
  - (7) electric log NO (yes or no)  
 (organization running log)
  - (8) how well bottom plugged BSW


description of formations encountered	from	to
Sand, Sd & Clay	0	7
Blue and Red Clay	7	18
Brown and Red Shell	18	30
White Clay	30	37
Silty Sand	37	45
White Clay	45	63
Sand	63	86
Blue Clay	86	103
Sandstone	103	120
Sand, w/ coarse gravel at bottom	120	160

DEPT. OF NATURAL RESOURCES  
 BUREAU OF LAND & WATER RESOURCES  
 DEC 29 1980  
 RECEIVED

DRILLERS REMARKS:

If well telescopes please sketch and show depths.

GROUND LEVEL

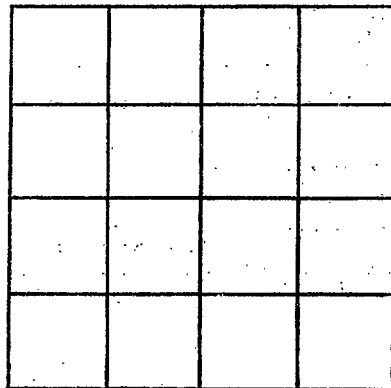

SECTION \_\_\_\_\_

Please indicate well location X.

ADDITIONAL INFORMATION

If more than one screen,  
show locations of each on sketch.