

MISSISSIPPI DEPARTMENT OF NATURAL RESOURCES
Bureau of Land and Water Resources
 Southport Mall
 P.O. Box 10631
 Jackson, Mississippi 39209
WATER WELL DRILLERS LOG

WAYNE
0 2268
6-11-81

June 11 1981 date well completed Bonte Drilling & Log firm name Wayne county well located

LANDOWNER: William Mayfield
 Rt 4 Waynesboro (mailing address)

description of formations encountered	from	to
clay	0	20
rest sand	20	30
med white sand	30	57
slight on clay		
32' 1" P.V.C. drage pipe		
sand would not produce at bottom		

WELL LOCATION:
 sec 27 T 20 N R 6 E
 3 miles SE Waynesboro (distance) (direction) (nearest town)

WELL PURPOSE:
 (home, irrigation, municipal, industrial)


- WELL COMPLETION DATA:**
- (1) diameter (inches) 2"
 - (2) total depth (feet) 40'
 - (3) static water level (feet) 32' (below top of ground)
 - (4) casing PVC 35' (material) (depth)
 2' (size) if telescope see back.
 - (5) screen 5' 35' (length) (depth to top)
 2' 6 slot S.S. (size) (material)
 - (6) pump 1 12 (HP) (yield gpm)
 elec. (type power)
 - (7) electric log no (yes or no)
 - (organization running log)
 - (8) how well bottom plugged 2' sand shank

DRILLERS REMARKS:



If well telescopes please sketch and show depths.

GROUND LEVEL

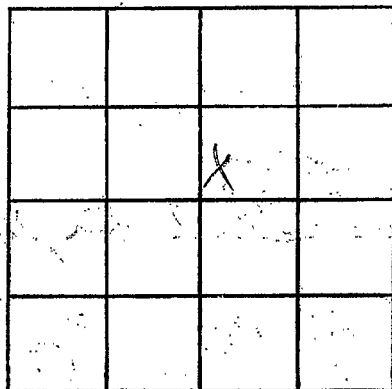

SECTION 27

Please indicate well location X.

ADDITIONAL INFORMATION

If more than one screen,
show locations of each on sketch.