

W. Wayne  
0 2070

**MISSISSIPPI  
 BOARD OF WATER COMMISSIONERS  
 416 North State Street  
 Jackson, Mississippi 39201**

**WATER WELL DRILLERS LOG**

11-28 1981 CARRS Well SERV WAYNE  
 date well completed firm name county well located

LANDOWNER: John Adam  
WAYNEBORO MS  
 (mailing address)

WELL LOCATION:  
 sec. 6-T-8(N) R. 6 E  
1/4 miles NINE of WAYNEBORO  
 (distance) (direction) (nearest town)

WELL PURPOSE: Home  
 (home, irrigation, municipal, industrial)

- WELL COMPLETION DATA:
- (1) diameter (inches) 2"
  - (2) total depth (feet) 120
  - (3) static water level (feet) 84 below top of ground.
  - (4) casing PVC 115'  
 (material) (depth)  
 (size) if telescope see back.
  - (5) screen 5" 115'  
 (length) (depth to top)  
2" PVC  
 (size) (material)
  - (6) pump 1 7  
 (HP) (yield gpm)  
Elect  
 (type power)
  - (7) electric log NO  
 (yes or no)  
 (organization running log)
  - (8) how well bottom plugged 2" CAP


description of formations encountered	depth	
	from	to
Top Soil	0	1
Red SAND	1	12
Coarse white sand	12	30
BROKEN pink+white		
Clay with sand	30	35
Blue MARL	35	43
Lime Rock	43	44
GRAY shale + Rock	44	55
<del>GRAY</del> Lime Rock	55	61
HARD Lime Rock	61	62
BROKEN Lime Rock +		
GRAY shale	62	66
GRAY shale	66	71
HARD Lime Rock	71	72
SOFT Lime Rock	72	73
HARD Lime Rock	73	75
SOFT Lime Rock	75	76
HARD Lime Rock	76	77
Lime clay	77	85
Fine Blue SAND	85	120
Still in same		
when quit		

DRILLERS REMARKS: SAND  
PACKED well

DEPT. OF NATURAL RESOURCES  
 BUREAU OF LAND & WATER RESOURCES  
 JAN 18 1982  
**RECEIVED**

If well telescopes please sketch and show depths.

GROUND LEVEL

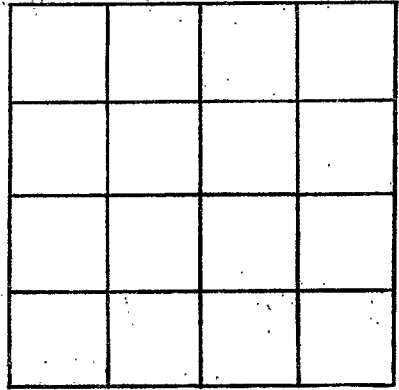

SECTION \_\_\_\_\_

Please indicate well location X.

ADDITIONAL INFORMATION

If more than one screen, show locations of each on sketch.