

Wayne
0 2072

MISSISSIPPI
BOARD OF WATER COMMISSIONERS
416 North State Street
Jackson, Mississippi 39201

WATER WELL DRILLERS LOG

4-28 1982 CARRS Well Serv WAYNE
date well completed firm name county well located

LANDOWNER: Eugene Bonner Rb

Rt 4 WAYNESBORO MS
(mailing address)

WELL LOCATION:
sec 35 T-8 N R-6 E
2 miles EAST of WINCHESTER
(distance) (direction) (nearest town)

WELL PURPOSE: HOME
(home, irrigation, municipal, industrial)

WELL COMPLETION DATA:

- (1) diameter (inches) 2"
- (2) total depth (feet) 63
- (3) static water level (feet) 23 below above top of ground.
- (4) casing PVC 58
(material) (depth)
(size) if telescope see back.
- (5) screen 5 58
(length) (depth to top)
1/4 Stainless Steel
(size) (material)
- (6) pump 1 12
(HP) (yield gpm)
Elec +
(type power)
- (7) electric log No
(yes or no)
(organization running log)
- (8) how well bottom plugged 1/2 plug

DRILLERS REMARKS: Puffed
up to 63' & made well

description of formations encountered	from	to
TOP SOIL	0	1
Yellow SAND	1	7
Red SAND	7	10
COARSE Yellow Sd w/ CLAY	10	17
Pink + white CLAY	17	18
COARSE white Sd w/ CLAY	18	28
BLACK MARL	28	30
BROWN CLAY	30	32
COARSE white SD	32	40
PEARL RAVEL	40	53
COARSE white SAND	53	63
Fine white SAND	63	67


DEPT. OF NATURAL RESOURCES
BUREAU OF LAND & WATER RESOURCES

MAY 18 1982

RECEIVED

If well telescopes please sketch and show depths.

GROUND LEVEL

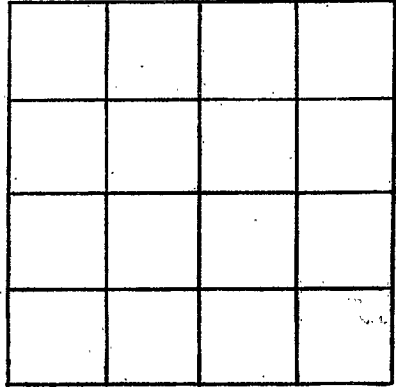

SECTION _____

Please indicate well location X.

ADDITIONAL INFORMATION

If more than one screen,
show locations of each on sketch.