

**MISSISSIPPI DEPARTMENT OF NATURAL RESOURCES**  
**Bureau of Land and Water Resources**  
 Southport Mall  
 P.O. Box 10631  
 Jackson, Mississippi 39209  
**WATER WELL DRILLERS LOG**

Wayne  
0  
2073

July 22 1982 Porter Drilling & Log Wayne  
 date well completed firm name county well located

LANDOWNER:	description of formations encountered	from	to
<u>Eddie Buck</u> <u>Rt 4 Waynesboro, Ms.</u> (mailing address)	Clay & sand	0	15
	Coarse sand	15	36
	Clay	36	50
	med coarse sand	50	76
	fine sand some		
	Clay	76	81
	stop at on clay		
<b>WELL LOCATION:</b> sec. <u>17</u> T. <u>8</u> N. R. <u>6</u> E. <u>2</u> miles <u>SE</u> of <u>Waynesboro</u> (distance) (direction) (nearest town)			
<b>WELL PURPOSE:</b> <u>dom</u> (home, irrigation, municipal, industrial)			
<b>WELL COMPLETION DATA:</b>			
(1) diameter (inches) <u>2"</u>			
(2) total depth (feet) <u>81</u>			
(3) static water level (feet) <u>69</u> <u>(below)</u> top of ground. <u>above</u>			
(4) casing <u>P.V.C.</u> <u>76'</u> (material) (depth)			
<u>2"</u> (size) if telescope see back.			
(5) screen <u>5'</u> <u>76'</u> (length) (depth to top)			
<u>2"</u> <u>below 5' S.</u> (size) (material)			
(6) pump <u>1</u> <u>4</u> (HP) (yield gpm)			
<u>elec.</u> (type power)			
(7) electric log <u>no</u> (yes or no)			
(organization running log)			
(8) how well bottom plugged <u>2 sand stark</u>			
DRILLERS REMARKS:			

74' 1" P.V.C. log pipe


DEPT. OF NATURAL RESOURCES  
 BUREAU OF LAND & WATER RESOURCES

SEP - 1 1982

**RECEIVED**

If well telescopes please sketch and show depths.

GROUND LEVEL

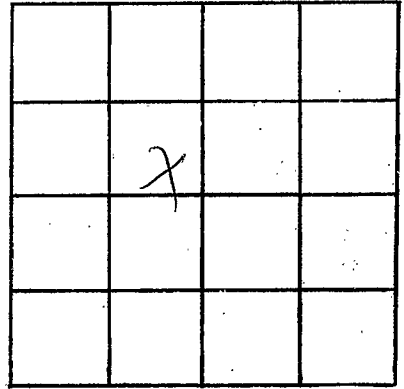

SECTION 17

Please indicate well location X.

ADDITIONAL INFORMATION

If more than one screen,  
show locations of each on sketch.