

Wayne
0
2074

MISSISSIPPI
BOARD OF WATER COMMISSIONERS
416 North State Street
Jackson, Mississippi 39201

WATER WELL DRILLERS LOG

Oct 10 1983 C.P. Clark Water Wells Wayne
date well completed firm name county well located

LANDOWNER: Keith Shantz
1216 Spring St.
Wynedon, Mo. 39367
(mailing address)

description of formations encountered	from	to
<u>Sand & sandy clay</u>	<u>0</u>	<u>13</u>
<u>Clay w/ soft streaks</u>	<u>13</u>	<u>20</u>
<u>Clay, soft</u>	<u>20</u>	<u>53</u>
	<u>53</u>	<u>60</u>

WELL LOCATION:
sec. 20 T 8 N R 6 E
3 miles SE of Wynedon
(distance) (direction) (nearest town)

WELL PURPOSE: Home
(home, irrigation, municipal, industrial)

- WELL COMPLETION DATA:
- (1) diameter (inches) 3
 - (2) total depth (feet) 54
 - (3) static water level (feet) 28 below top of ground.
 - (4) casing PVC 47'
(material) (depth)
 - (size) if telescope see back.
 - (5) screen 5' 47
(length) (depth to top)
 - 2" Stainless Steel
(size) (material)
 - (6) pump 1 9
(HP) (yield gpm)
 - 220V 1φ
(type power)
 - (7) electric log no
(yes or no)
 - (organization running log)
 - (8) how well bottom plugged BWV

DRILLERS REMARKS:


DEPT. OF NATURAL RESOURCES
BUREAU OF LAND & WATER RESOURCES

001 26 1983

RECEIVED

If well telescopes please sketch and show depths.

GROUND LEVEL

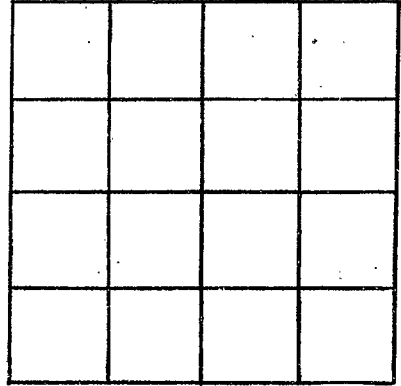

SECTION _____

Please indicate well location X.

ADDITIONAL INFORMATION

If more than one screen,
show locations of each on sketch.