

Wayne
02076

MISSISSIPPI
BOARD OF WATER COMMISSIONERS
416 North State Street
Jackson, Mississippi 39201

WATER WELL DRILLERS LOG

11-2-83 Camwell-SEK Wayne
date well completed firm name county well located

LANDOWNER: Milton Hayes
RT 4 WAYNESboro MS
(mailing address)

WELL LOCATION:
sec 25 T 8 N S R 6 E W
3 1/2 miles SSSE of Waynesboro
(distance) (direction) (nearest town)

WELL PURPOSE: Home
(home, irrigation, municipal, industrial)

- WELL COMPLETION DATA:
- (1) diameter (inches) 20" V
 - (2) total depth (feet) 75
 - (3) static water level (feet) 50 below above top of ground.
 - (4) casing PVC 70
(material) (depth)
(size) If telescope see back.
 - (5) screen 3' 70
(length) (depth to top)
2" PVC
(size) (material)
 - (6) pump 1 5
(HP) (yield gpm)
Elect
(type power)
 - (7) electric log No
(yes or no)
 - (organization running log)
 - (8) how well bottom plugged 2" CAP

description of formations encountered	from	to
TOP SOIL	0	1
2 1/2" SD w/ 2 1/2" CLAY	1	8
Red SD w/ CLAY	8	15
Coarse Red SD	15	21
white CLAY	21	24
Coarse 2 1/2" SD	24	35
Coarse white SD	35	55
white CLAY	55	57
Coarse white SD	57	65
med white SD	65	75
BROKEN white SD + white CLAY	75	80
Duff in same		

DEPT. OF NATURAL RESOURCES
BUREAU OF LAND & WATER RESOURCES


NOV 28 1983

RECEIVED

DRILLERS REMARKS:

If well telescopes please sketch and show depths.

GROUND LEVEL

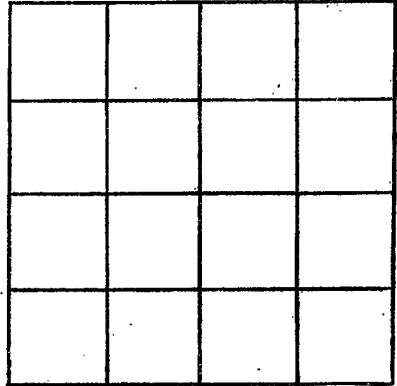

SECTION _____

Please indicate well location X.

ADDITIONAL INFORMATION

If more than one screen, show locations of each on sketch.