

**MISSISSIPPI DEPARTMENT OF NATURAL RESOURCES**  
**Bureau of Land and Water Resources**  
 Southport Mall  
 P.O. Box 10631  
 Jackson, Mississippi 39209  
**WATER WELL DRILLERS LOG**

Wayne  
O 2078

Dec 18 1983 Perkins Drilling & Log Wayne  
 date well completed firm name county well located

LANDOWNER: Ellen Skow  
Box 4 Box 614  
Waynesboro Miss  
 (mailing address)

description of formations encountered	from	to
<u>clay</u>	<u>0</u>	<u>34</u>
<u>sand</u>	<u>34</u>	<u>56</u>
<u>sand &amp; clay</u>	<u>56</u>	<u>60</u>
<u>fine coarse sand</u>	<u>60</u>	<u>62</u>
<u>fine sand &amp; clay</u>	<u>62</u>	<u>70</u>

WELL LOCATION:  
 sec. 27 T. 80 N. R. 6 E.  
3 miles SE of Waynesboro  
 (distance) (direction) (nearest town)

WELL PURPOSE: home  
 (home, irrigation, municipal, industrial)

- WELL COMPLETION DATA:
- diameter (inches) 2
  - total depth (feet) 68
  - static water level (feet) 40 <sup>below</sup> / <sub>above</sub> top of ground.
  - casing PVC (material), 63 (depth)  
2 (size) if telescope see back.
  - screen 5 (length), 63 (depth to top)  
2 (size), 6 shot SS (material)
  - pump 1 (HP), 8 (yield gpm)  
elec. (type power)
  - electric log no (yes or no)  
 (organization running log)

(8) how well bottom plugged 2 sand shock

DRILLERS REMARKS:

51' PVC drop pipe


DEPT. OF NATURAL RESOURCES  
 BUREAU OF LAND & WATER RESOURCES

JAN 16 1984

**RECEIVED**

If well telescopes please  
sketch and show depths.

GROUND LEVEL

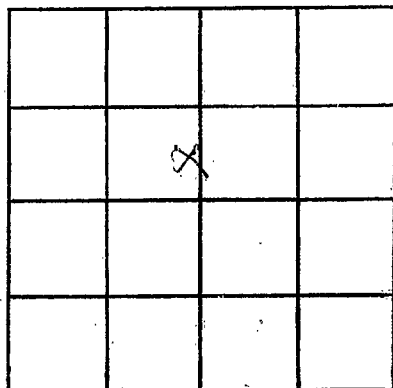

SECTION 27

Please indicate well location X.

ADDITIONAL INFORMATION

If more than one screen,  
show locations of each on sketch.