

MISSISSIPPI DEPARTMENT OF NATURAL RESOURCES

Bureau of Land and Water Resources

Southport Mall

P.O. Box 10631

Jackson, Mississippi 39209

WATER WELL DRILLERS LOG

Wayne  
0 2080

3/8/84 19 CAROL'S WELL SER WAYNE  
date well completed firm name county well located

LANDOWNER: JESSIE BAYSENTS  
PT. WAYNESBORO  
MS. 39368  
(mailing address)

WELL LOCATION:  
sec. 20 T 8 N R 6 E S  
3 miles S of WAYNESBORO  
(distance) (direction) (nearest town)

WELL PURPOSE: HOME  
(home, irrigation, municipal, industrial)

WELL COMPLETION DATA:  
(1) diameter (inches) 2"  
(2) total depth (feet) 70'  
(3) static water level (feet) 30' below top of ground.  
(4) casing PVC, 65'  
(material) (depth)  
(size) if telescope see back.  
(5) screen 5', 65'  
(length) (depth to top)  
2" PVC.  
(size) (material)  
(6) pump 1 12  
(HP) (yield gpm)  
ELEC  
(type power)  
(7) electric log NO  
(yes or no)  
(organization running log)  
(8) how well bottom plugged 2' CAP

Description of formations encountered	from	to
TOP SOIL	0	2
YEL. SD.	2	8
" CLY.	8	10
" WH. CLAY	10	14
CHARGE SD	14	23
BROKEN WT. CLY.	23	40
BLUE CLY	40	41
WH. SD + BR. CLY.	41	54
CH. BR. + WH. SD	54	61
WH. CLY	61	62
WT. + MED. SD	62	65
WH. CLY	65	66
MED. WH. SD.	66	70

DRILLERS REMARKS:


DEPT. OF NATURAL RESOURCES  
BUREAU OF LAND & WATER RESOURCES

APR 12 1984

RECEIVED

If well telescopes please  
sketch and show depths.

GROUND LEVEL

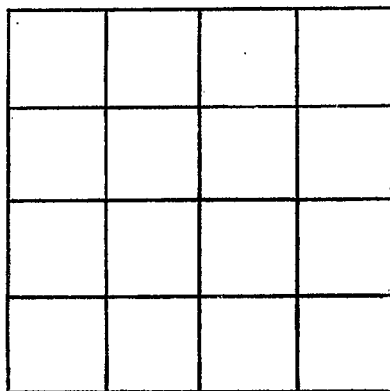

SECTION \_\_\_\_\_

Please indicate well location X.

ADDITIONAL INFORMATION

If more than one screen,  
show locations of each on sketch.