

MISSISSIPPI DEPARTMENT OF NATURAL RESOURCES
Bureau of Land and Water Resources
 Southport Mall
 P.O. Box 10631
 Jackson, Mississippi 39209
WATER WELL DRILLERS LOG

Wayne
0 2021

4/5/84 19 CARR'S WELL SER. WAYNE
 date well completed firm name county well located

LANDOWNER: OSCAR JORDAN
RT. 4, WAYNESBORO
MS. 39367
 (mailing address)

WELL LOCATION:
 sec. 20 T. 20 S. R. 6E
3 miles S of WAYNESBORO
 (distance) (direction) (nearest town)

WELL PURPOSE: HOM
 (home, irrigation, municipal, industrial)

WELL COMPLETION DATA:

(1) diameter (inches) 2"

(2) total depth (feet) 50

(3) static water level (feet) 12 ^{below} _{above} top of ground.

(4) casing PVC, 45
 (material) (depth)
 (size) if telescope see back.

(5) screen 5', 45
 (length) (depth to top)
2", PVC
 (size) (material)

(6) pump 1/2, 10
 (HP) (yield gpm)
ELEC.
 (type power)

(7) electric log NO
 (yes or no)
 (organization running log)

(8) how well bottom plugged 2" PVC CAP.

DRILLERS REMARKS:

description of formations encountered	from to	
<u>TOP SOIL</u>	<u>0</u>	<u>1</u>
<u>R.D. SD. CLY</u>	<u>1</u>	<u>17</u>
<u>CW. SD W/PC</u>	<u>17</u>	<u>22</u>
<u>CL. CLY</u>	<u>22</u>	<u>26</u>
<u>YN. WH. SD.</u>	<u>26</u>	<u>30</u>
<u>CL. CLY.</u>	<u>30</u>	<u>38</u>
<u>CL. BR. SD</u>	<u>38</u>	<u>50</u>
<u>STILL IN SAME</u>		


DEPT. OF NATURAL RESOURCES
 BUREAU OF LAND & WATER RESOURCES

APR 12 1984

RECEIVED

If well telescopes please sketch and show depths.

GROUND LEVEL

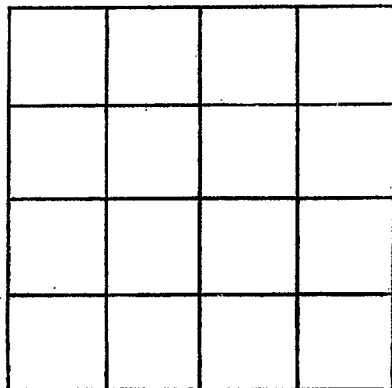

SECTION _____

Please indicate well location X:

ADDITIONAL INFORMATION

If more than one screen, show locations of each on sketch.