

**MISSISSIPPI DEPARTMENT OF NATURAL RESOURCES**  
**Bureau of Land and Water Resources**  
 Southport Mall  
 P.O. Box 10631  
 Jackson, Mississippi 39209  
**WATER WELL DRILLERS LOG**

Wayne  
02082

4/15/84 19 CAROL WELL SER WAYNE  
 date well completed firm name county well located

LANDOWNER: STEVE JONES  
R.T. 4 WAYNESBORO  
MS. 39367  
 (mailing address)

description of formations encountered	from	to
TOP SOIL	0	2
R.D. SD CLY.	2	15
C.R. SD	15	26
MED. TO FN. SD.	24	32
MED. WH. S.D.	32	35
C.R. WH. S.D.	35	40

WELL LOCATION:  
 sec. 20 T. 80N R. 6E  
3 miles S of WAYNESBORO  
 (distance) (direction) (nearest town)

WELL PURPOSE: HOMES  
 (home, irrigation, municipal, industrial)

- WELL COMPLETION DATA:
- (1) diameter (inches) 2"
  - (2) total depth (feet) 40
  - (3) static water level (feet) 12 below above top of ground.
  - (4) casing PVC, 35'  
 (material) (depth)  
 (size) if telescope see back.
  - (5) screen 5, 35'  
 (length) (depth to top)  
2", PVC  
 (size) (material)
  - (6) pump 1/2, 10  
 (HP) (yield gpm)  
ELEC.  
 (type power)
  - (7) electric log NO  
 (yes or no)
  - (8) how well bottom plugged 2" PVC  
CAP

DRILLERS REMARKS:


DEPT. OF NATURAL RESOURCES  
 BUREAU OF LAND & WATER RESOURCES

APR 12 1984

**RECEIVED**

If well telescopes please  
sketch and show depths.

GROUND LEVEL

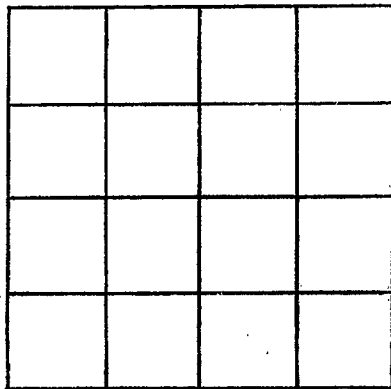

SECTION \_\_\_\_\_

Please indicate well location X.

ADDITIONAL INFORMATION

If more than one screen,  
show locations of each on sketch.