

MISSISSIPPI DEPARTMENT OF NATURAL RESOURCES

Bureau of Land and Water Resources

Southport Mall

P.O. Box 10631

Jackson, Mississippi 39209

WATER WELL DRILLERS LOG

Wayne  
02083

4/16/84 19 CARB'S WELL SER WAYNE  
date well completed firm name county well located

LANDOWNER: E. J. HOLDER  
PT. 4 WAYNES BORO  
MS, 39367  
(mailing address)

WELL LOCATION:  
sec. 10 T. 8 N. R. 6 E. W  
5 miles EAST of WAYNESBORO  
(distance) (direction) (nearest town)

WELL PURPOSE: Home  
(home, irrigation, municipal, industrial)

WELL COMPLETION DATA:

- (1) diameter (inches) 2"
- (2) total depth (feet) 75'
- (3) static water level (feet) 30 below above top of ground.
- (4) casing PVC 70'  
(material) (depth)  
if telescope see back.  
(size)
- (5) screen 5' 70'  
(length) (depth to top)  
2" PVC  
(size) (material)
- (6) pump 1 14  
(HP) (yield gpm)  
ELEC.  
(type power)
- (7) electric log NO  
(yes or no)  
(organization running log)
- (8) how well bottom plugged 1" PVC  
CAP

description of formations encountered	from	to
TOP 30' L	0	2
RD. SD, CLY	2	4
RD. CLY	4	18
L. WH. SD.	18	25
BRK. WH. CLY & MD. SD.	25	40
ME. WH. SD.	40	50
CR. WH. SD.	50	58
CR. YEL. & BR. SD.	58	61
CR. WH. SD.	61	65
PER. GRAVEL	65	75

DEPT. OF NATURAL RESOURCES  
BUREAU OF LAND & WATER RESOURCES


APR 12 1984

RECEIVED

DRILLERS REMARKS:

If well telescopes please sketch and show depths.

GROUND LEVEL

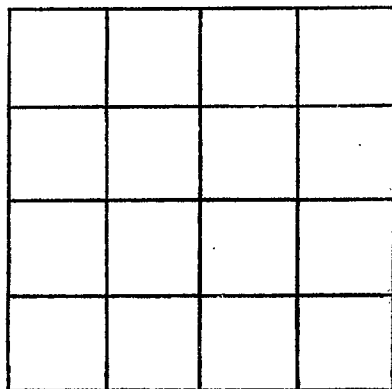

SECTION \_\_\_\_\_

Please indicate well location X.

ADDITIONAL INFORMATION

If more than one screen,  
show locations of each on sketch.