

MISSISSIPPI DEPARTMENT OF NATURAL RESOURCES

Bureau of Land and Water Resources

Southport Mall

P.O. Box 10631

Jackson, Mississippi 39209

WATER WELL DRILLERS LOG

Wayne
 2084

5/1/84 date well completed
 CARR'S WELL SER. firm name
 WAYNE county well located

LANDOWNER: COTTRON WILFIELD

description of formations encountered	from	to
---------------------------------------	------	----

74 WAYNESBORO
 MS 39367
 (mailing address)

TOP SOIL	0	2
RED SANDY CLAY	2	15
CWSO	15	24
MED FINE SD	24	32
MED W SD	32	38
COARSE W SD	38	40

WELL LOCATION:
 sec. 20 T. 8 S. R. 6 E. W. 3
 3 miles S of WAYNESBORO
 (distance) (direction) (nearest town)

WELL PURPOSE: HOME
 (home, irrigation, municipal, industrial)

WELL COMPLETION DATA:

- (1) diameter (inches) 2"
- (2) total depth (feet) 40'
- (3) static water level (feet) 2 below above top of ground.
- (4) casing PVC 40'
 (material) (depth)
- (5) screen 5' 35'
 (length) (depth to top)
- (6) pump 1/2 HP 10 (yield gpm)
 (size) (material) PVC
- (7) electric log (yes or no)
 (organization running log) ELEC

(8) how well bottom plugged 2" PVC cap

DRILLERS REMARKS:


MISSISSIPPI DEPARTMENT OF NATURAL RESOURCES
 BUREAU OF LAND & WATER RESOURCES

MAY 16 1984

RECEIVED

If well telescopes please sketch and show depths.

GROUND LEVEL

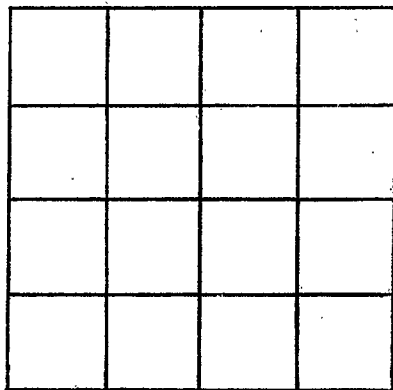

SECTION _____

Please indicate well location X.

ADDITIONAL INFORMATION

If more than one screen,
show locations of each on sketch.