

MISSISSIPPI DEPARTMENT OF NATURAL RESOURCES

Bureau of Land and Water Resources

Southport Mall

P.O. Box 10631

Jackson, Mississippi 39209

WATER WELL DRILLERS LOG

WAYNE
D
2085

Feb 3 1986 date well completed
26 Porter Drilling & Log firm name
Itasca county well located

LANDOWNER William Morgan
At 6 Box 191 A
Waynesboro Ms.
(mailing address)

description of formations encountered	from	to
Clay	0	23
sand & clay	23	25
Clay	25	39
thin rock		39
Course to meet sand	37	47
interbed on clay		

WELL LOCATION:
sec. 17 T. 8 N. R. 6 E.
S. (W)
2 miles SE of Waynesboro
(distance) (direction) (nearest town)

WELL PURPOSE: Home
(home, irrigation, municipal, industrial)

36' 1" P.V. Comp pipe

- WELL COMPLETION DATA:
- diameter (inches) 2"
 - total depth (feet) 47
 - static water level (feet) 18 (below/above top of ground)
 - casing P.V.C 42'
(material) (depth)
2 if telescope see back.
(size)
 - screen 5' 42'
(length) (depth to top)
2" 8 slot P.V.C
(size) (material)
 - pump 1/2 chiller 5
(HP) (yield gpm)
elec.
(type power)
 - electric log no
(yes or no)

back work valve placed
will left hand on top
male threads up
2" chest tange above screen

(organization running log)

(8) how well bottom plugged
2 back work valve

RECEIVED


FEB 11 1986

DRILLERS REMARKS:

Department of Natural Resources
Bureau of Land & Water Resources

If well telescopes please sketch and show depths.

GROUND LEVEL,

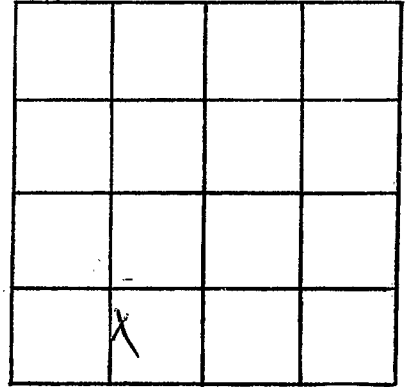

SECTION 17

Please indicate well location X.

ADDITIONAL INFORMATION

If more than one screen,
show locations of each on sketch.