

MISSISSIPPI DEPARTMENT OF NATURAL RESOURCES

Bureau of Land and Water Resources

Southport Mall

P.O. Box 10631

Jackson, Mississippi 39209

WATER WELL DRILLERS LOG

WAYNE
 0 2082

June 17 1986 date well completed
 86 Porter Drilling & Log firm name
 Wayne county well located


LANDOWNER: Jessie Knight
Rt. 4 Waynesboro, Ms
 (mailing address)

WELL LOCATION:
 sec. 17 T. 8 N. R. 6 E
2 miles SE of Waynesboro
 (distance) (direction) (nearest town)

WELL PURPOSE: Home
 (home, irrigation, municipal, industrial)

WELL COMPLETION DATA:
 (1) diameter (inches) 2'
 (2) total depth (feet) 34'
 (3) static water level (feet) 16' below above top of ground.
 (4) casing P.V.C., 29'
 (material) (depth)
2' if telescope see back.
 (size)
 (5) screen 5', 29'
 (length) (depth to top)
2", Salt P.V.C.
 (size) (material)
 (6) pump 1, 15
 (HP) (yield gpm)
elec.
 (type power)
 (7) electric log no
 (yes or no)
 (organization running log)

description of formations encountered	from	to
<u>0-Clay</u>	<u>0</u>	<u>10'</u>
<u>fine sand</u>	<u>10</u>	<u>20</u>
<u>Course sand</u>	<u>20</u>	<u>34</u>
<u>stagnant white steel</u>		
<u>oil sand</u>		
<u>23' 1" P.V.C. drop pipe</u>		

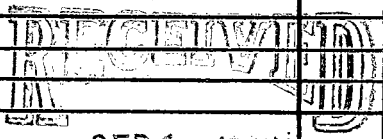

SEP 17 1986


Department of Natural Resources
 Bureau of Land & Water Resources

(8) how well bottom plugged
2' sand shank

DRILLERS REMARKS:
plugged with left hand pipe
make track up

If well telescopes please sketch and show depths.

GROUND LEVEL

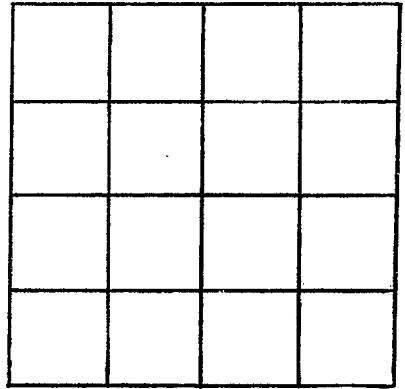

SECTION _____

Please indicate well location X.

ADDITIONAL INFORMATION

If more than one screen,
show locations of each on sketch.