

MISSISSIPPI DEPARTMENT OF NATURAL RESOURCES

Bureau of Land and Water Resources

Southport Mall

P.O. Box 10631

Jackson, Mississippi 39209

WATER WELL DRILLERS LOG

WAYNE
 # 2087

10 / 20 1986 CARBS WELL SER WAYNE
 date well completed firm name county well located

LANDOWNER: GLORIA McRAE description of formations encountered from to
 RT. 4 WAYNESBORO TOP SOIL 0 2
 D.S. 39367 SANDY CLAY 2 16
 (mailing address) COARSE SD 16 22
 CHALK 22 58
 ROCK 58 59 1/2
 SD & CHALK 59 62
 SD. SOME CH. 62 74

WELL LOCATION:
 sec. 14 T 8 N R. 6 E
 S W
 5 miles SE of WAYNESBORO
 (distance) (direction) (nearest town)

WELL PURPOSE:
 (home, irrigation, municipal, industrial)

WELL COMPLETION DATA:
 (1) diameter (inches) 2"
 (2) total depth (feet) 74
 (3) static water level (feet) 61 below top of ground.
 (4) casing PVC, 69' (material) (depth)
 2" (size) If telescope see back.
 (5) screen 5' 69' (length) (depth to top)
 2" 8 SLOT PVC (size) (material)
 (6) pump 1 (HP) 8 (yield gpm)
 ELEC (type power)
 (7) electric log NO (yes or no)
 (organization running log)
 (8) how well bottom plugged B.W.V.
 PLUGGED WITH L.H. WIPIC

RECEIVED


NOV 13 1986

Department of Natural Resources
 Bureau of Land & Water Resources

DRILLERS REMARKS:

If well telescopes please
sketch and show depths.

GROUND LEVEL

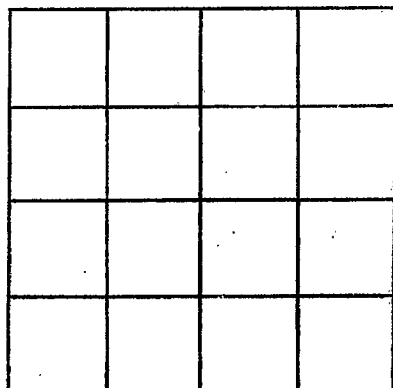

SECTION _____

Please indicate well location X.

ADDITIONAL INFORMATION

If more than one screen,
show locations of each on sketch.