

MISSISSIPPI DEPARTMENT OF NATURAL RESOURCES

Bureau of Land and Water Resources

Southport Mall

P.O. Box 10631

Jackson, Mississippi 39209

WATER WELL DRILLERS LOG

WAYNE  
 02088

11/20 1986 CARB'S WELL SER WAYNE  
 date well completed firm name county well located

LANDOWNER: <u>WILLIAM TATE</u>	description of formations encountered	from	to
<u>PT. 2 WAYNESBORO</u>			
<u>MS. 39367</u> (mailing address)	<u>TOP SOIL</u>	<u>0</u>	<u>1</u>
<u>sec. 15 T 2 N R 6 E S 1 W</u>	<u>SANDY CLAY</u>	<u>1</u>	<u>8</u>
<u>5</u> miles <u>S.E.</u> of <u>WAYNESBORO</u> (distance) (direction) (nearest town)	<u>CHALK</u>	<u>8</u>	<u>15</u>
<u>WELL LOCATION:</u>	<u>SAND</u>	<u>15</u>	<u>25</u>
<u>WELL PURPOSE: HOAG</u> (home, irrigation, municipal, industrial)	<u>CLAY</u>	<u>25</u>	<u>60</u>
<u>WELL COMPLETION DATA:</u>	<u>SD. CLAY</u>	<u>60</u>	<u>75</u>
(1) diameter (inches) <u>2'</u>	<u>MED. TO CR. SAND</u>	<u>75</u>	<u>85</u>
(2) total depth (feet) <u>85</u>			
(3) static water level (feet) <u>32</u> <u>below</u> top of ground.			
(4) casing <u>P.V.C.</u> <u>80</u> (material) (depth)			
<u>2"</u> If telescope see back. (size)			
(5) screen <u>5'</u> <u>80'</u> (length) (depth to top)			
<u>2"</u> <u>P.V.C.</u> (size) (material)			
(6) pump <u>1 HP.</u> <u>5'</u> (HP) (yield gpm)			
<u>ELEC.</u> (type power)			
(7) electric log <u>NO</u> (yes or no)			
(organization running log)			
(8) how well bottom plugged <u>PLUG CD</u> <u>B.W.V.</u>			
DRILLERS REMARKS:			


RECEIVED

DEC 15 1986

Department of Natural Resources  
 Bureau of Land & Water Resources

If well telescopes please sketch and show depths.

GROUND LEVEL

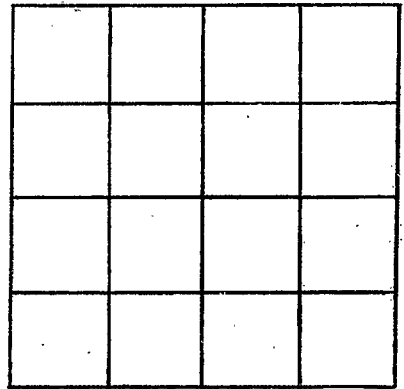

SECTION \_\_\_\_\_

Please indicate well location X.

ADDITIONAL INFORMATION

If more than one screen,  
show locations of each on sketch.